

SURVEY & REMONUMENTATION

JAN 22 1998

Re-Mon Liber 1 Page 127

LAND CORNER RECORDATION CERTIFICATE
Filing Requirement of Act 74, Mich. P.A. 1970

REMONUMENTATION SECTION

For Corners in
Huron
(County)

Located in: _____ Corner Code # _____

1. Public Land survey Winsor T 16 N R 10 E
T _____ R _____ F-13
G-13
T _____ R _____
T _____ R _____

2. Property Controlling S _____ T _____ R _____
in Section S _____ T _____ R _____
3. Miscellaneous S _____ T _____ R _____

4. Lot No. _____, Recorded Plat _____
5. Private Claims _____

STATE OF MICHIGAN
HURON COUNTY
RECORDED
9 DEC 97 11:13 A.M.
FRANCES L. HOLDWICK
REGISTER OF DEEDS
Register of Deeds Stamp & File Number

I, James T. Meek, in a field survey on October 30, 19 97, do hereby certify that under requirements of P.A. 74, Michigan P.A. of 1970, the corner points mentioned in lines 1 and 2 above were in conformance with regulations and rules thereof as required in the current manual of survey instructions of the United States Department of the Interior, Bureau of Land Management or by a decree of a Court of Law and/or that the corner points mentioned in lines 3, 4 and 5 above were in conformance with the rules of the Michigan Board of Land Surveyors or by a Decree of a Court of Law; established, re-established, monumented, re-monumented, recovered, found as expressed below:

A	B	C	D	E	F	G	H	I	J	K	L	M
2	6	5	4	3	2	1						
3												
4	7	8	9	10	11	12						
5												
6	18	17	16	15	14	13						
7												
8	19	20	21	22	23	24						
9												
10	30	29	28	27	26	25						
11												
12	31	32	33	34	35	36						
13												

NOTE: Not more than 4 corners, all in the same town and range, may be recorded on this certificate.

A. Description of original monument and accessories and/or subsequent restoration:
Original Survey South Bdy. T16NR10E, 1835, Harvey Parke, D.S.

F-13 South ¼ Corner of Section 33
Post
B. Ash 26", N79½°E, 37 links
Elm 13", N74°W, 44½ links

County surveyors record: none
Recorded surveys: L4, P286; L4, P680
LCRC: none

G-13 Corner of Sections 33 and 34
Post
Maple 16", N54½°W, 36 links
Cedar 8", N64½°E, 5 links

County surveyors record: ¾" iron
Recorded surveys: none
LCRC: none

B. Description of corner evidence found and/or method applied in restoring or reestablishing corner:

F-13 South ¼ Corner of Section 33

Found 1" iron in mon box
At centerline of Kilmanagh Rd.
Drain bears North

Accepted as the best available evidence
of the original corner position.

G-13 Corner of Sections 33 and 34

Found 1" pipe in mon box
5' West of intersection Kilmanagh & Brown
Rds.

Accepted as the best available evidence
of the original corner position.

C. Description of monument for corner and accessories established to perpetuate locating the position of the corner:

F-13 South ¼ Corner of Section 33

1" iron in mon box

From which:
½" iron flush w/grd. bears N45E, 20.0'
½" iron flush w/grd. bears S45E, 20.0'
½" iron flush w/grd. bears S45W, 20.0'
½" iron flush w/grd. bears N45W, 20.0'


G-13 Corner of Sections 33 and 34

1" pipe in mon box

From which:
½" iron flush w/grd. bears N45E, 37.0'
Tag in PP bears S45°E, 81.8'
Road sign post bears S35°W, 43.8'
Road sign post bears N18°W, 34.3'

Signed by [Signature]
Surveyor's Michigan License No. 39089

Date _____

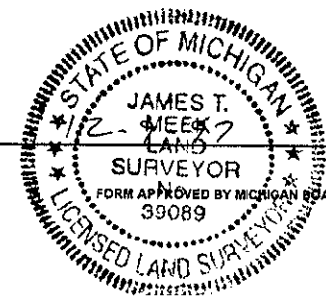

APPROVED AT PEER BOARD MEETING, Nov 25, 1997 RLB