

**SURVEY & REMONUMENTATION**

JAN 22 1998

*Re-Mon Liber 1 Page 126*

**SECTION**

**LAND CORNER RECORDATION CERTIFICATE**  
Filing Requirement of Act 74, Mich. P.A. 1970

**REMONUMENTATION**

For Corners in

	<u>Huron</u> (County)	Located in:	Corner Code #
1. Public Land survey	Winsor	T 16 N R 10 E	H-13
		T _____ R _____	I-13
		T _____ R _____	
		T _____ R _____	
2. Property Controlling in Section	S _____	T _____ R _____	
	S _____	T _____ R _____	
3. Miscellaneous	S _____	T _____ R _____	

STATE OF MICHIGAN  
HURON COUNTY  
RECORDED

9 DEC 97 11:13 A.M.

FRANCES L. HOLDWICK  
REGISTER OF DEEDS

Register of Deeds Stamp & File Number

4. Lot No. \_\_\_\_\_, Recorded Plat \_\_\_\_\_  
5. Private Claims \_\_\_\_\_

	A	B	C	D	E	F	G	H	I	J	K	L	M
2	6		5		4		3		2		1		
3													
4	7		8		9		10		11		12		
5													
6	18		17		16		15		14		13		
7													
8	19		20		21		22		23		24		
9													
10	30		29		28		27		26		25		
11													
12	31		32		33		34		35		36		
13													

I, James T. Meek, in a field survey on October 30, 1997, do hereby certify that under requirements of P.A. 74, Michigan P.A. of 1970, the corner points mentioned in lines 1 and 2 above were in conformance with regulations and rules thereof as required in the current manual of survey instructions of the United States Department of the Interior, Bureau of Land Management or by a decree of a Court of Law and/or that the corner points mentioned in lines 3, 4 and 5 above were in conformance with the rules of the Michigan Board of Land Surveyors or by a Decree of a Court of Law; established, re-established, monumented, re-monumented, recovered, found as expressed below:

NOTE: Not more than 4 corners, all in the same town and range, may be recorded on this certificate.

A. Description of original monument and accessories and/or subsequent restoration:  
Original survey South Bdy. T16NR10E, 1835, Harvey Parke, D.S.

H-13 South ¼ Corner of Section 34  
Post  
B. Ash 9", N55°E, 33 links  
Cedar 22", N50½°W, 46½ links  
  
County surveyors record: ¾" iron  
Recorded surveys: none  
LCRC: none

I-13 Corner of Sections 34 and 35  
Post  
Hemlock 10", N80°E, 27 links  
Hemlock 9", N13½°W, 9½ links  
  
County surveyors record: stone over pipe  
Recorded surveys: L1, P515; L3, P748  
LCRC: none

B. Description of corner evidence found and/or method applied in restoring or reestablishing corner:

H-13 South ¼ Corner of Section 34  
  
Found 1" iron in mon box  
At centerline Kilmanagh Rd.  
Field line bears North  
West, 10'± field line bears South  
  
Accepted as the best available evidence of the original corner position.

I-13 Corner of Sections 34 and 35  
  
Found empty mon box  
At intersection of Kilmanagh & Caseville Rds.  
  
Accepted as the best available evidence of the original corner position.


C. Description of monument for corner and accessories established to perpetuate locating the position of the corner:

H-13 South ¼ Corner of Section 34  
  
Set ½" iron with cap #39089, 2" below grd., over iron  
  
From which:  
½" iron flush w/grd. bears N45°E, 20.0'  
½" iron flush w/grd. bears S45°E, 20.0'  
Tag in PP bears S16°W, 54.5'  
½" iron flush w/grd. bears N45W, 20.0'

I-13 Corner of Sections 34 and 35  
  
Set ½" iron w/cap #39089 in mon box  
  
From which:  
Road sign post bears N58°E, 42.3'  
Tag in PP bears S27°E, 58.6'  
Road sign post bears S58°W, 35.8'  
Gas line post bears N24°W, 73.4'

Signed by [Signature]  
Surveyor's Michigan License No. 39089

Date \_\_\_\_\_

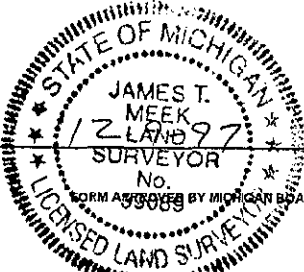

PROVED AT PEER BOARD MEETING, Nov. 25, 1997 RLB