

**SURVEY & REMONUMENTATION**

JAN 22 1998

*Re-Mon Liber 1 Page 125*

REMONUMENTATION SECTION

LAND CORNER RECORDATION CERTIFICATE  
Filing Requirement of Act 74, Mich. P.A. 1970

For Corners in	Located in:	Corner Code #
<u>Huron</u> (County)		
1. Public Land survey	Winsor T <u>16</u> N R <u>10</u> E	J-13 K-13
2. Property Controlling in Section	S _____ T _____ R _____	_____
3. Miscellaneous	S _____ T _____ R _____	_____

STATE OF MICHIGAN  
HURON COUNTY  
RECORDED  
9 DEC 97 11:13 A.M.  
FRANCES L. HOLDWICK  
REGISTER OF DEEDS

Register of Deeds Stamp & File Number

4. Lot No. \_\_\_\_\_, Recorded Plat \_\_\_\_\_  
5. Private Claims \_\_\_\_\_

	A	B	C	D	E	F	G	H	I	J	K	L	M
2	6		5		4		3		2		1		
3													
4	7		8		9		10		11		12		
5													
6	18		17		16		15		14		13		
7													
8	19		20		21		22		23		24		
9													
10	30		29		28		27		26		25		
11													
12	31		32		33		34		35		36		
13													

I, James T. Meek, in a field survey on October 30, 1997, do hereby certify that under requirements of P.A. 74, Michigan P.A. of 1970, the corner points mentioned in lines 1 and 2 above were in conformance with regulations and rules thereof as required in the current manual of survey instructions of the United States Department of the Interior, Bureau of Land Management or by a decree of a Court of Law and/or that the corner points mentioned in lines 3, 4 and 5 above were in conformance with the rules of the Michigan Board of Land Surveyors or by a Decree of a Court of Law; established, re-established, monumented, re-monumented, recovered, found as expressed below:

NOTE: Not more than 4 corners, all in the same town and range, may be recorded on this certificate.

A. Description of original monument and accessories and/or subsequent restoration:  
Original Survey South Bdy. T16NR10E, 1835, Harvey Parke, D.S.

J-13 South 1/4 Corner of Section 35  
Post  
Elm 22", N87°E, 23 links  
Hemlock 24", N32°W, 21 links  
  
County surveyors record: 3/4" iron in post  
Recorded surveys: L3, P748; L4, P617  
LCRC: none

K-13 Corner of Sections 35 and 36  
Post  
Birch 22", N57°E, 40 links  
Lynn 7", N64°W, 86 links  
  
County surveyors record: iron in post  
Recorded surveys: none  
LCRC: none

B. Description of corner evidence found and/or method applied in restoring or reestablishing corner:

J-13 South 1/4 Corner of Section 35  
  
Found 1" iron in mon box  
4' South of centerline Kilmanagh Rd.  
  
Accepted as the best available evidence of the original corner position.


K-13 Corner of Sections 35 and 36  
  
There is no remaining evidence of the original corner position.

C. Description of monument for corner and accessories established to perpetuate locating the position of the corner:

J-13 South 1/4 Corner of Section 35  
  
1" iron in mon box  
  
From which:  
Tag in PP bears N8°E, 80.5'  
Tag in PP bears S45°E, 62.'  
NE corner of house bears S32°W, 72.4'  
SE corner of house bears N53°W, 97.8'

K-13 Corner of Sections 35 and 36  
  
At proportionate distance  
Set 1/2" iron w/cap #39089 in mon box  
4' East of intersection Kilmanagh & Notter Rds.  
From which:  
Fence post bears N67°E, 42.7'  
East leg of direct. sign bears S3°W, 17.6'  
Road sign post bears S37°W, 33.0'  
Road sign post bears N36°W, 51.25'  
1" iron mon box bears West, 49.6'

Signed by James T. Meek Date \_\_\_\_\_  
Surveyor's Michigan License No. 39089

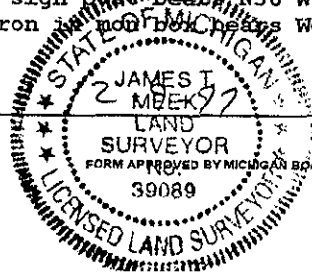

APPROVED AT PEER BOARD MEETING, Nov. 25, 1997 RLD

FORM APPROVED BY MICHIGAN BOARD OF LAND SURVEYORS, JAN. 28, 1971  
REVISED MAY 14, 1975  
REVISED JAN., 1983