

JAN 22 1998

Re-Mon Liber 1 Page 124

SECTION REMONUMENTATION

LAND CORNER RECORDATION CERTIFICATE Filing Requirement of Act 74, Mich. P.A. 1970

For Corners in

Located in:	Corner Code #
<u>Huron</u> (County)	
1. Public Land survey Winsor T <u>16 N R 10 E</u>	<u>L-13</u>
	M-13
2. Property Controlling S T R	
in Section S T R	
3. Miscellaneous S T R	

STATE OF MICHIGAN HURON COUNTY RECORDED

9 DEC 97 11:12 A.M.

FRANCES L. HOLWICK REGISTER OF DEEDS

Register of Deeds Stamp & File Number

4. Lot No. \_\_\_\_\_, Recorded Plat \_\_\_\_\_  
5. Private Claims \_\_\_\_\_

I, James T. Meek, in a field survey on October 30, 1997, do hereby certify that under requirements of P.A. 74, Michigan P.A. of 1970, the corner points mentioned in lines 1 and 2 above were in conformance with regulations and rules thereof as required in the current manual of survey instructions of the United States Department of the Interior, Bureau of Land Management or by a decree of a Court of Law and/or that the corner points mentioned in lines 3, 4 and 5 above were in conformance with the rules of the Michigan Board of Land Surveyors or by a Decree of a Court of Law; established, re-established, monumented, re-monumented, recovered, found as expressed below.

A	B	C	D	E	F	G	H	I	J	K	L	M
2	6	5	4	3	2	1						
3												
4	7	8	9	10	11	12						
5												
6	18	17	16	15	14	13						
7												
8	19	20	21	22	23	24						
9												
10	30	29	28	27	26	25						
11												
12	31	32	33	34	35	36						
13												

NOTE: Not more than 4 corners, all in the same town and range, may be recorded on this certificate.

A. Description of original monument and accessories and/or subsequent restoration: Original Survey South Bdy. T16NR10E, 1835, Harvey Parke, D.S.

L-13 South 1/4 Corner of Section 36 Post Birch 16", N45 1/2°E, 8 links Hemlock 9", N70°W, 19 links  County surveyors record: none Recorded surveys: none LCRC: none	M-13 Corner of Townships 15 and 16 North, Ranges 10 and 11 East Post B. Ash 17", S43°E, 14 links Birch 10", N62 1/2°W, 19 links County surveyors record: none Recorded surveys: L3, P45; I4, P32 LCRC: none
--	---


B. Description of corner evidence found and/or method applied in restoring or reestablishing corner:

L-13 South 1/4 Corner of Section 36  Found 1" iron in mon box 1' North of centerline Kilmanagh Rd.  Accepted as the best available evidence of original corner position	M-13 Corner of Townships 15 and 16 North, Ranges 10 and 11 East  Found 1" pipe bent at surface of pavement At intersection of Kilmanagh Rd. and Gagetown Rds.  Accepted as the best available evidence of original corner position
--	---

C. Description of monument for corner and accessories established to perpetuate locating the position of the corner:

L-13 South 1/4 Corner of Section 36  1" iron in mon box  From which: 1/2" iron, flush w/grd. bears N45°E, 18.0' 1/2" iron, flush w/grd. bears S45°E, 20.0' 1/2" iron, flush w/grd. bears S45°W, 20.0' 1/2" iron, flush w/grd. bears N45°W, 20.0'	M-13 Corner of Townships 15 and 16 North, Ranges 10 and 11 East  3/4" iron in mon box at pipe location  From which: Road sign post bears N64°E, 36.6' Tag in PP bears S47°E, 69.1' Road sign post bears S56°W, 37.5' Telephone box bears N37°W, 56.4'
--	---

Signed by [Signature] Date \_\_\_\_\_  
Surveyor's Michigan License No. 39089

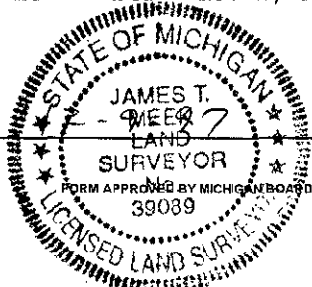

APPROVED AT PEER BOARD MEETING, Nov. 25, 1997 RLB