

Common to: M13 - McKinley Twp. - T17N-R10E
 A13 - Chandler Twp. - T17N-R11E
 A01 - Oliver Twp. - T16N-R11E

Re-Mon Liber 1, Page 200

1998 REMONUMENTATION

LAND CORNER RECORDATION CERTIFICATE
 Filing Requirement of Act 74, Mich. P.A. 1970

STATE OF MICHIGAN
 HURON COUNTY
 RECORDED

For Corners in

<u>Huron</u> (County)	Located in:	Corner Code #
1. Public Land survey	Winsor T 16 N R 10 E	M-1
	T _____ R _____	
	T _____ R _____	
	T _____ R _____	
2. Property Controlling in Section	S _____ T _____ R _____	
	S _____ T _____ R _____	
3. Miscellaneous	S _____ T _____ R _____	

SURVEY &
 REMONUMENTATION
 JAN 28 1999
 SECTION

11 DEC 98 9:45 A.M.
 FRANCES L. HOLDWICK
 REGISTER OF DEEDS

Register of Deeds Stamp & File Number

4. Lot No. _____, Recorded Plat _____
 5. Private Claims _____

A	B	C	D	E	F	G	H	I	J	K	L	M
2	6	5	4	3	2	1						
3												
4	7	8	9	10	11	12						
5												
6	18	17	16	15	14	13						
7												
8	19	20	21	22	23	24						
9												
10	30	29	28	27	26	25						
11												
12	31	32	33	34	35	36						
13												

I, James T. Meek, in a field survey on October 30, 1998, do hereby certify that under requirements of P.A. 74, Michigan P.A. of 1970, the corner points mentioned in lines 1 and 2 above were in conformance with regulations and rules thereof as required in the current manual of survey instructions of the United States Department of the Interior, Bureau of Land Management or by a decree of a Court of Law and/or that the corner points mentioned in lines 3, 4 and 5 above were in conformance with the rules of the Michigan Board of Land Surveyors or by a Decree of a Court of Law; established, re-established, monumented, re-monumented, recovered, found as expressed below:

NOTE: Not more than 4 corners, all in the same town and range, may be recorded on this certificate.

A. Description of original monument and accessories and/or subsequent restoration:
 Original Survey North Bdy. T16NR10E, 1835, Harvey Parke, D.S.

M-1 Corner of Townships 16 and 17 North, Ranges 10 & 11 East
 Post
 B. Ash 22", S62°E, 36 links
 Birch 10", S75°W, 4 links
 County surveyors record; iron shaft
 Recorded surveys: none
 LCRC: none

B. Description of corner evidence found and/or method applied in restoring or reestablishing corner:


M-1 Corner of Townships 16 and 17 North, Ranges 10 & 11 East
 Found 1" iron in mon box
 At intersection of Berne & Gagetown Rds.
 Accepted as the best available evidence of the original corner position.

C. Description of monument for corner and accessories established to perpetuate locating the position of the corner:

M-1 Corner of Townships 16 and 17 North, Ranges 10 & 11 East
 1" iron in mon box
 From which:
 Concrete row marker bears N54°E, 45.6'
 Road sign post bears S26°E, 34.0'
 Concrete row marker bears S47°W, 54.1'
 Tag on power pole bears N65°W, 75.75'

Signed by [Signature] Date December 8, 1998

Surveyor's Michigan License No. 39089

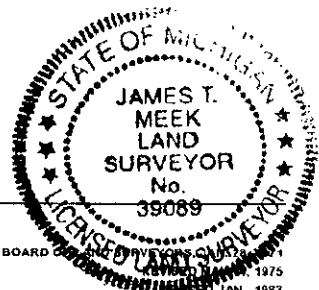

APPROVED AT PEER BOARD MEETING, Bruce L. Brown 11-24-98