

*Common to M01 - Brookfield Twp. - T15N-R10E
 *Common to A01 - Grant Twp. - T15N-R11E
 *Common to A13 - Oliver Twp. - T16N-R11E

Re-Mon Liber 1 Page 124

LAND CORNER RECORDATION CERTIFICATE
 Filing Requirement of Act 74, Mich. P.A. 1970

REMONUMENTATION

For Corners in

<u>Huron</u> (County)	Located in:	Corner Code #
1. Public Land survey	Winsor T 16 N R 10 E	L-13
	T _____ R _____	<u>M-13</u>
	T _____ R _____	_____
	T _____ R _____	_____
2. Property Controlling in Section	S _____ T _____ R _____	_____
	S _____ T _____ R _____	_____
3. Miscellaneous	S _____ T _____ R _____	_____

SURVEY & REMONUMENTATION

STATE OF MICHIGAN
 HURON COUNTY
 RECORDED

JAN 22 1998

9 DEC 97 11:12 A.M.

SECTION

FRANCES L. HOLIDWICK
 REGISTER OF DEEDS

Register of Deeds Stamp & File Number

4. Lot No. _____, Recorded Plat _____
 5. Private Claims _____

A	B	C	D	E	F	G	H	I	J	K	L	M
2	6	5	4	3	2	1						
3												
4	7	8	9	10	11	12						
5												
6	18	17	16	15	14	13						
7												
8	19	20	21	22	23	24						
9												
10	30	29	28	27	26	25						
11												
12	31	32	33	34	35	36						
13												

I, James T. Meek, in a field survey on October 30, 1997, do hereby certify that under requirements of P.A. 74, Michigan P.A. of 1970, the corner points mentioned in lines 1 and 2 above were in conformance with regulations and rules thereof as required in the current manual of survey instructions of the United States Department of the Interior, Bureau of Land Management or by a decree of a Court of Law and/or that the corner points mentioned in lines 3, 4 and 5 above were in conformance with the rules of the Michigan Board of Land Surveyors or by a Decree of a Court of Law; established, re-established, monumented, re-monumented, recovered, found as expressed below:

NOTE: Not more than 4 corners, all in the same town and range, may be recorded on this certificate.

A. Description of original monument and accessories and/or subsequent restoration:
 Original Survey South Bdy. T16NR10E, 1835, Harvey Parke, D.S.

L-13 South ¼ Corner of Section 36
 Post
 Birch 16", N45½°E, 8 links
 Hemlock 9", N70°W, 19 links
 County surveyors record: none
 Recorded surveys: none
 LCRC: none

M-13 Corner of Townships 15 and 16 North,
 Ranges 10 and 11 East
 Post
 B. Ash 17", S43°E, 14 links
 Birch 10", N62½°W, 19 links
 County surveyors record: none
 Recorded surveys: L3, P45; L4, P32
 LCRC: none

B. Description of corner evidence found and/or method applied in restoring or reestablishing corner:

L-13 South ¼ Corner of Section 36
 Found 1" iron in mon box
 1' North of centerline Kilmanagh Rd.
 Accepted as the best available evidence of original corner position

M-13 Corner of Townships 15 and 16 North,
 Ranges 10 and 11 East
 Found 1" pipe bent at surface of pavement
 At intersection of Kilmanagh Rd. and
 Gagetown Rds.
 Accepted as the best available evidence of original corner position


C. Description of monument for corner and accessories established to perpetuate locating the position of the corner:

L-13 South ¼ Corner of Section 36
 1" iron in mon box
 From which:
 ½" iron, flush w/grd. bears N45°E, 18.0'
 ½" iron, flush w/grd. bears S45°E, 20.0'
 ½" iron, flush w/grd. bears S45°W, 20.0'
 ½" iron, flush w/grd. bears N45°W, 20.0'

M-13 Corner of Townships 15 and 16 North,
 Ranges 10 and 11 East
 ¾" iron in mon box at pipe location
 From which:
 Road sign post bears N64°E, 36.6'
 Tag in PP bears S47°E, 69.1'
 Road sign post bears S56°W, 37.5'
 Telephone box bears N37°W, 56.4'

Signed by [Signature]
 Surveyor's Michigan License No. 39089

Date _____

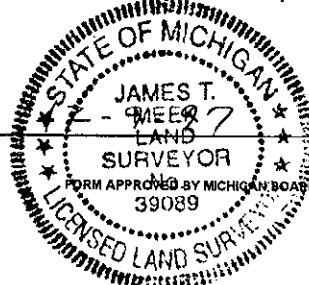

APPROVED AT PEER BOARD MEETING, Nov. 25, 1997 RLB