

\*Common to M13 - Winsor Twp. - T16N-R10E  
 \*Common to M01 - Brookfield Twp. - T15N-R10E  
 \*Common to A01 - Grant Twp. - T15N-R11E

*Re-Mon Liber 1 Page 121*

REMONUMENTATION

LAND CORNER RECORDATION CERTIFICATE  
 Filing Requirement of Act 74, Mich. P.A. 1970

For Corners in

	Located in:	Corner Code #
<u>Huron</u> (County)		
1. Public Land survey: Oliver	T <u>16 N</u> R <u>11 E</u>	<u>A-13</u> ✓
	T <u>15 N</u> R <u>11 E</u>	<u>A-1</u>
	T <u>16 N</u> R <u>10 E</u>	<u>M-13</u>
	T <u>15 N</u> R <u>10 E</u>	<u>M-1</u>
2. Property Controlling in Section	S ___ T ___ R ___	___
	S ___ T ___ R ___	___
3. Miscellaneous	S ___ T ___ R ___	___

STATE OF MICHIGAN  
 HURON COUNTY  
 RECORDED

9 DEC 97 11:12 A.M.

FRANCES L. HOLDWICK  
 REGISTER OF DEEDS

Register of Deeds Stamp & File Number

4. Lot No. \_\_\_\_\_, Recorded Plat \_\_\_\_\_  
 5. Private Claims \_\_\_\_\_

I, James T. Meek, in a field survey on October 30, 1997, do hereby certify that under requirements of P.A. 74, Michigan P.A. of 1970, the corner points mentioned in lines 1 and 2 above were in conformance with regulations and rules thereof as required in the current manual of survey instructions of the United States Department of the Interior, Bureau of Land Management or by a decree of a Court of Law and/or that the corner points mentioned in lines 3, 4 and 5 above were in conformance with the rules of the Michigan Board of Land Surveyors or by a Decree of a Court of Law; established, re-established, monumented, re-monumented, recovered, found as expressed below:

	A	B	C	D	E	F	G	H	I	J	K	L	M
2	6		5		4		3		2		1		
3													
4	7		8		9		10		11		12		
5													
6	18		17		16		15		14		13		
7													
8	19		20		21		22		23		24		
9													
10	30		29		28		27		26		25		
11													
12	31		32		33		34		35		36		
13													

NOTE: Not more than 4 corners, all in the same town and range, may be recorded on this certificate.

A. Description of original monument and accessories and/or subsequent restoration:  
 Original Survey South Bdy. T16NR11E, 1835, Harvey Parke, D.S.  
 A-13 Corner of Townships 15 and 16 North, Ranges 10 and 11 East  
 Post  
 B. Ash 17", S43°E, 14 links  
 Birch 10", N62½°W, 19 links  
 County surveyors record: none  
 Recorded surveys: L3, P45; L4, P12  
 LCRC: none


B. Description of corner evidence found and/or method applied in restoring or reestablishing corner:  
 A-13 Corner of Townships 15 and 16 North Ranges 10 and 11 East  
 Found 1" pipe bent at surface of pavement  
 At intersection of Kilmanagh Rd. and Gagetown Rds.  
 Accepted as the best available evidence of original corner position

**SURVEY & REMONUMENTATION**

**JAN 22 1998**

**SECTION**

C. Description of monument for corner and accessories established to perpetuate locating the position of the corner:  
 A-13 Corner of Townships 15 and 16 North, Ranges 10 and 11 East  
 ¾" iron in mon box at pipe location  
 From which:  
 Road sign post bears N64°E, 36.6'  
 Tag in PP bears S47°E, 69.1'  
 Road sign post bears S56°W, 37.5'  
 Telephone box bears N37°W, 56.4'

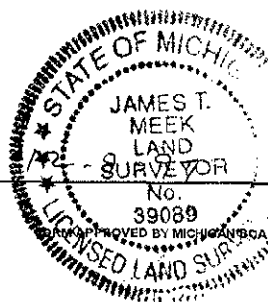

Signed by [Signature] Date \_\_\_\_\_  
 Surveyor's Michigan License No. 39089

APPROVED AT PEER BOARD MEETING Nov. 25, 1997 RLB