

**SURVEY & REMONUMENTATION**

JAN 22 1998

*Re-Mon Liber 1 Page 120*

**LAND CORNER RECORDATION CERTIFICATE**  
**Filing Requirement of Act 74, Mich. P.A. 1970**

STATE OF MICHIGAN  
 HURON COUNTY  
 RECORDED

9 DEC 97 11:12 A.M.

FRANCES L. HOLDWICK  
 REGISTER OF DEEDS

Register of Deeds Stamp & File Number

For Corners in	Located in:	Corner Code #
<u>Huron</u> (County)		
1. Public Land survey	Oliver T <u>16 N</u> R <u>11 E</u>	<u>B-13</u> <u>C-13</u>
	T _____ R _____	_____
	T _____ R _____	_____
	T _____ R _____	_____
	T _____ R _____	_____
2. Property Controlling in Section	S _____ T _____ R _____	_____
	S _____ T _____ R _____	_____
3. Miscellaneous	S _____ T _____ R _____	_____

4. Lot No. \_\_\_\_\_, Recorded Plat \_\_\_\_\_  
 5. Private Claims \_\_\_\_\_

	A	B	C	D	E	F	G	H	I	J	K	L	M
2	6		5		4		3		2		1		
3													
4	7		8		9		10		11		12		
5													
6	18		17		16		15		14		13		
7													
8	19		20		21		22		23		24		
9													
10	30		29		28		27		26		25		
11													
12	31		32		33		34		35		36		
13													

I, James T. Meek, in a field survey on October 30, 1997, do hereby certify that under requirements of P.A. 74, Michigan P.A. of 1970, the corner points mentioned in lines 1 and 2 above were in conformance with regulations and rules thereof as required in the current manual of survey instructions of the United States Department of the Interior, Bureau of Land Management or by a decree of a Court of Law and/or that the corner points mentioned in lines 3, 4 and 5 above were in conformance with the rules of the Michigan Board of Land Surveyors or by a Decree of a Court of Law; established, re-established, monumented, re-monumented, recovered, found as expressed below:

NOTE: Not more than 4 corners, all in the same town and range, may be recorded on this certificate.

A. Description of original monument and accessories and/or subsequent restoration:  
 Original Survey South Bdy. T16NR11E, 1835, Harvey Parke, D.S.

B-13 South ¼ Corner of Section 31  
 Post  
 Aspen 7", N57°E, 13 links  
 Hemlock 9", N76°W, 33 links

County surveyors record: ¾" iron  
 Recorded surveys: L3, P45; L4, P32  
 LCRC: none

C-13 Corner of Sections 31 and 32  
 Post  
 Hemlock 8", N34½°W, 3½ links  
 Hemlock 15", N57°E, 7 links

County surveyors record: iron rod  
 Recorded surveys: none  
 LCRC: none

B. Description of corner evidence found and/or method applied in restoring or reestablishing corner:

B-13 South ¼ Corner of Section 31  
 Found 1" pipe, 3" deep  
 At intersection of Kilmanagh & Born Rds.  
 Accepted as the best available evidence of the original corner position.


C-13 Corner of Sections 31 and 32  
 Found 1" pipe bent, 1" below grd.  
 1' North of intersection Kilmanagh & Maxwell Rds.  
 Accepted as the best available evidence of the original corner position.

C. Description of monument for corner and accessories established to perpetuate locating the position of the corner:

B-13 South ¼ Corner of Section 31  
 Set ½" iron with cap #39089, 3" below grd., over 1" iron  
 From which:  
 ½" iron flush w/grd. bears N45°E, 30.0'  
 Tag in PP bears S45°E, 64.6'  
 East leg of direct. sign bears S7°W, 14.8'  
 Road sign post bears N35°W, 32.7'

C-13 Corner of Sections 31 and 32  
 Set ½" iron w/cap #39089 2" below grd. over pipe  
 From which:  
 ½" iron flush w/grd. bears N45°E, 37.0'  
 Road sign post bears S32°E, 37.8'  
 ½" iron flush w/grd. bears S45°W, 31.0'  
 Road sign post bears N38°W, 31.5'

Signed by [Signature] Date \_\_\_\_\_  
 Surveyor's Michigan License No. 39089

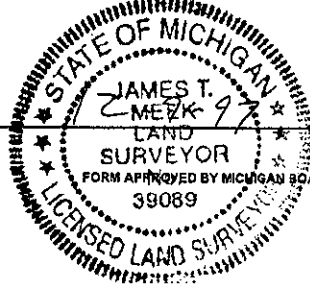

APPROVED AT PEER BOARD MEETING, Nov. 25, 1997 RLB

FORM APPROVED BY MICHIGAN BOARD OF LAND SURVEYORS, JAN. 28, 1971  
 REVISED MAY 14, 1975  
 REVISED JAN, 1983