

SURVEY & REMONUMENTATION

JAN 22 1998

REMONUMENTATION SECTION

LAND CORNER RECORDATION CERTIFICATE
Filing Requirement of Act 74, Mich. P.A. 1970

Re-Mon. Liber 1 Page 118

For Corners in
Huron
(County)

Located in: _____ Corner Code # _____

1. Public Land survey Oliver T 16 N R 11 E F-13
T _____ R _____ G-13
T _____ R _____
T _____ R _____

2. Property Controlling S _____ T _____ R _____
in Section S _____ T _____ R _____

3. Miscellaneous S _____ T _____ R _____

STATE OF MICHIGAN
HURON COUNTY
RECORDED
9 DEC 97 11:11 A.M.
FRANCES L. HOLDWICK
REGISTER OF DEEDS

Register of Deeds Stamp & File Number

4. Lot No. _____, Recorded Plat _____
5. Private Claims _____

I, James T. Meek, in a field survey on October 30, 1997, do hereby certify that under requirements of P.A. 74, Michigan P.A. of 1970, the corner points mentioned in lines 1 and 2 above were in conformance with regulations and rules thereof as required in the current manual of survey instructions of the United States Department of the Interior, Bureau of Land Management or by a decree of a Court of Law and/or that the corner points mentioned in lines 3, 4 and 5 above were in conformance with the rules of the Michigan Board of Land Surveyors or by a Decree of a Court of Law; established, re-established, monumented, re-monumented, recovered, found as expressed below:

A	B	C	D	E	F	G	H	I	J	K	L	M
2	6	5	4	3	2	1						
3												
4	7	8	9	10	11	12						
5												
6	18	17	16	15	14	13						
7												
8	19	20	21	22	23	24						
9												
10	30	29	28	27	26	25						
11												
12	31	32	33	34	35	36						
13												

NOTE: Not more than 4 corners, all in the same town and range, may be recorded on this certificate.

A. Description of original monument and accessories and/or subsequent restoration:
Original Survey South Bdy. T16NR11E, 1835, Harvey Parke, D.S.

<p>F-13 South ¼ Corner of Section 33 Post Birch 10", N76°E, 8 links Birch 10", N62½°W, 8½ links</p> <p>County surveyors record: none Recorded surveys: none LCRC: none</p>	<p>G-13 Corner of Sections 33 and 34 Post Hemlock 26", N48½°E, 18 links B. Ash 10", N49°W, 27 links</p> <p>County surveyors record: iron pipe Recorded surveys: L2, P211; L2, P243; L3, P662 LCRC: none</p>
---	--


B. Description of corner evidence found and/or method applied in restoring or reestablishing corner:

<p>F-13 South ¼ Corner of Section 33</p> <p>Found 1" iron, 4" deep At centerline of Kilmanagh Rd. Fence line bears North</p> <p>Accepted as the best available evidence of the original corner position.</p>	<p>G-13 Corner of Sections 33 and 34</p> <p>Found 1½" iron in mon box 1' East of intersection Kilmanagh & Elkton Rds.</p> <p>Accepted as the best available evidence of the original corner position.</p>
---	--

C. Description of monument for corner and accessories established to perpetuate locating the position of the corner:

<p>F-13 South ¼ Corner of Section 33</p> <p>Set ½" iron with cap #39089, 3" below grd., over 1" iron</p> <p>From which: Tag in fence post bears N8E, 34.8' Telephone box bears S28°E, 41.2' Tag in 16" spruce bears S4°W, 37.0' Tag in fence post bears N19°W, 37.9'</p>	<p>G-13 Corner of Sections 33 and 34</p> <p>1½" iron in mon box</p> <p>From which: Road sign post bears N65°E, 43.1' Tag in 12" spruce bears S47°W, 49.2' Tag in Wood post by TB bears N17°W, 77.0' 1" iron in mon box bears West, 4.0'</p>
---	--

Signed by [Signature] Date _____
Surveyor's Michigan License No. 39089

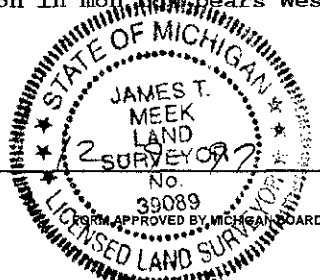

APPROVED AT PEER BOARD MEETING, Nov. 25, 1997 RLB

FORM APPROVED BY MICHIGAN BOARD OF LAND SURVEYORS, JAN. 28, 1971
REVISED MAY 14, 1975
REVISED JAN., 1983