

SURVEY & REMONUMENTATION

JAN 22 1998

Re-Mon Liber 1 Page 117

REMONUMENTATION SECTION

LAND CORNER RECORDATION CERTIFICATE
Filing Requirement of Act 74, Mich. P.A. 1970

For Corners in
Huron Located in: Corner Code #
(County)

1. Public Land survey Oliver T 16 N R 11 E H-13
T R I-13
T R
T R

2. Property Controlling S T R
in Section S T R
3. Miscellaneous S T R

4. Lot No. _____, Recorded Plat _____
5. Private Claims _____

STATE OF MICHIGAN
HURON COUNTY
RECORDED
9 DEC 97 11:11 A.M.
FRANCES L. HOLDWICK
REGISTER OF DEEDS

Register of Deeds Stamp & File Number

I, James T. Meek, in a field survey on October 30, 1997, do hereby certify that under requirements of P.A. 74, Michigan P.A. of 1970, the corner points mentioned in lines 1 and 2 above were in conformance with regulations and rules thereof as required in the current manual of survey instructions of the United States Department of the Interior, Bureau of Land Management or by a decree of a Court of Law and/or that the corner points mentioned in lines 3, 4 and 5 above were in conformance with the rules of the Michigan Board of Land Surveyors or by a Decree of a Court of Law; established, re-established, monumented, re-monumented, recovered, found as expressed below:

	A	B	C	D	E	F	G	H	I	J	K	L	M
2	6	5	4	3	2	1							
3													
4	7	8	9	10	11	12							
5													
6	18	17	16	15	14	13							
7													
8	19	20	21	22	23	24							
9													
10	30	29	28	27	26	25							
11													
12	31	32	33	34	35	36							
13													

NOTE: Not more than 4 corners, all in the same town and range, may be recorded on this certificate.

A. Description of original monument and accessories and/or subsequent restoration:
Original survey South Bdy. T16NR11E, 1835, Harvey Parke, D.S.

H-13 South ¼ Corner of Section 34
Post
Hemlock 13", N23°W, 8 links
Cedar 9", N40½°E, 32 links

County surveyors record: iron rod
Recorded surveys: L2, P243
LCRC: none

I-13 Corner of Sections 34 and 35
Post
Hemlock 9", N88°E, 7 links
Hemlock 12", N49½°W, 33 links

County surveyors record: iron rod
Recorded surveys: L1, P347; L2, P145; L3, P488; L4, P480; L4, P545; L4, P546
LCRC: none

B. Description of corner evidence found and/or method applied in restoring or reestablishing corner:

H-13 South ¼ Corner of Section 34

Found iron in rock collar, 2' deep
1' North of centerline Kilmanagh Rd.
Fence line bears North

Accepted as the best available evidence of the original corner position.

I-13 Corner of Sections 34 and 35

Found 1" iron 6" below grd.
1' North of intersection of Kilmanagh & Hartsell Rds. (North)

Accepted as the best available evidence of the original corner position.

C. Description of monument for corner and accessories established to perpetuate locating the position of the corner:

H-13 South ¼ Corner of Section 34

Set ½" iron with cap #39089, 3" below grd., over iron


From which:
Tag in 12" triple ash bears N10°E, 39.3'
½" iron flush w/grd. bears S45°E, 25.0'
1½" iron bears S88°W, 22.3'
Tag in 12" twin cedar bears N2°W, 43.55'

I-13 Corner of Sections 34 and 35

Set ½" iron w/cap #39089 2" below grd. over iron

From which:
Gas line sign post bears N52°E, 53.7'
Road sign post bears S10°E, 32.35'
Tag in PP bears S58°W, 65.25'
Road sign post bears N45°W, 47.2'
1" iron bears West 11.15'

Prepared by James T. Meek Date _____
Surveyor's Michigan License No. 39089
PROVED AT PEER BOARD MEETING, Nov 25, 1997 RLB

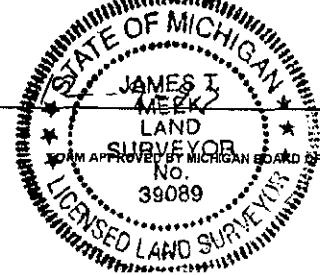

FORM APPROVED BY MICHIGAN BOARD OF LAND SURVEYORS, JAN. 28, 1971
REVISED MAY 14, 1975
REVISED JAN., 1983