SURVEY & REMONUMENTATION

JAN 2 2 1998

REMONUMENTATION SECTION

Re-Mon Liber 1 Page 116

LAND CORNER RECORDATION CERTIFICATE
Filing Requirement of Act 74, Mich. P.A. 1970

For Corners in
Huron (County)

	Located in:			Corner Code #
1. Public Land survey	Oliver	T 16 N	R 11 E	J-13
		T ____	R ____	K-13
		T ____	R ____	
		T ____	R ____	
2. Property Controlling	S ____	T ____	R ____	
in Section	S ____	T ____	R ____	
3. Miscellaneous	S ____	T ____	R ____	

STATE OF MICHIGAN
HURON COUNTY
RECORDED

9 DEC 97 11:11 A.M.

FRANCES L. HOLDWICK
REGISTER OF DEEDS

Register of Deeds Stamp & File Number

4. Lot No. _____, Recorded Plat _____
5. Private Claims _____

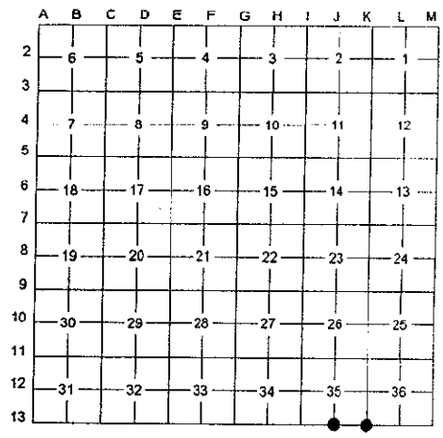

I, James T. Meek, in a field survey on October 30, 19 97, do hereby certify that under requirements of P.A. 74, Michigan P.A. of 1970, the corner points mentioned in lines 1 and 2 above were in conformance with regulations and rules thereof as required in the current manual of survey instructions of the United States Department of the Interior, Bureau of Land Management or by a decree of a Court of Law and/or that the corner points mentioned in lines 3, 4 and 5 above were in conformance with the rules of the Michigan Board of Land Surveyors or by a Decree of a Court of Law; established, re-established, monumented, re-monumented, recovered, found as expessed below:

NOTE: Not more than 4 corners, all in the same town and range, may be recorded on this certificate.

A. Description of original monument and accessories and/or subsequent restoration:
Original Survey South Bdy. T16NR11E, 1835, Harvey Parke, D.S.

J-13 South ¼ Corner of Section 35
Post
W. Ash 11", N47°W, 10 links
Cedar 6", N84°E, 21½ links

County surveyors record: none
Recorded surveys: L1, P347
LCRC: none

K-13 Corner of Sections 35 and 36
Post
Aspen 9", N84½°E, 28 links
Cedar 9", N9°W, 1 links

County surveyors record: none
Recorded surveys: L3, P362
LCRC: none

B. Description of corner evidence found and/or method applied in restoring or reestablishing corner:

J-13 South ¼ Corner of Section 35

Found 1" iron
4' South of centerline Kilmanagh Rd.
Occupation line bears North

Accepted as the best available evidence of the original corner position.

K-13 Corner of Sections 35 and 36

There is no remaining evidence of the original corner position.

C. Description of monument for corner and accessories established to perpetuate locating the position of the corner:

J-13 South ¼ Corner of Section 35

Set ½" iron with cap #39089, 2" below grd., over iron

From which:
Tag in 6" sq. post bears N11°E, 34.65'
Tag in PP bears S57°E, 84.5'
Tag in 8" Elm bears S74°W, 78.4'
1" iron bears West, 23.15'

K-13 Corner of Sections 35 and 36

At proportionate distance
Set ½" iron w/cap #39089 2" below grd.
2' South of int Kilmanagh & Moore Rds.
From which:
Telephone box bears N33°E, 67.1'
East leg of dirct. sign bears South, 14.4'
Road sign post bears S37°W, 32.0'
Road sign post bears N18°W, 60.5'
½" iron bears S88°W, 39.6'

Signed by _____ Date _____

Surveyor's Michigan License No. 39089

APPROVED AT PEER BOARD MEETING, Nov 25, 1997 RLB

STATE OF MICHIGAN
JAMES T. MEEK
LAND SURVEYOR
No. 39089
LICENSED LAND SURVEYOR

FORM APPROVED BY MICHIGAN BOARD OF LAND SURVEYORS, JAN. 28, 1971
REVISED MAY 14, 1975
REVISED JAN. 1983