

*Common to M01 - Grant Twp. - T15N-R11E
 *Common to A01 - Sheridan Twp. - T15N-R12E
 *Common to A13 - Colfax Twp. - T16N-R12E

Re-Mon Liber 1 Pg. 115

REMONUMENTATION

LAND CORNER RECORDATION CERTIFICATE
 Filing Requirement of Act 74, Mich. P.A. 1970

For Corners in
Huron
 (County)

Located in: _____ Corner Code # _____

1. Public Land survey Oliver T 16 N R 11 E L-13
 T _____ R _____ M-13
 T _____ R _____
 T _____ R _____

2. Property Controlling S _____ T _____ R _____
 in Section S _____ T _____ R _____

3. Miscellaneous S _____ T _____ R _____

4. Lot No. _____, Recorded Plat _____

5. Private Claims _____

SURVEY &
 REMONUMENTATION

STATE OF MICHIGAN
 HURON COUNTY
 RECORDED

JAN 22 1998

9 DEC 97 11:11 A.M.

SECTION

FRANCES L. HOLLOWICK
 REGISTER OF DEEDS

Register of Deeds Stamp & File Number

	A	B	C	D	E	F	G	H	I	J	K	L	M
2	6		5		4		3		2		1		
3													
4	7		8		9		10		11		12		
5													
6	18		17		16		15		14		13		
7													
8	19		20		21		22		23		24		
9													
10	30		29		28		27		26		25		
11													
12	31		32		33		34		35		36		
13													

I, James T. Meek, in a field survey on October 30, 1997, do hereby certify that under requirements of P.A. 74, Michigan P.A. of 1970, the corner points mentioned in lines 1 and 2 above were in conformance with regulations and rules thereof as required in the current manual of survey instructions of the United States Department of the Interior, Bureau of Land Management or by a decree of a Court of Law and/or that the corner points mentioned in lines 3, 4 and 5 above were in conformance with the rules of the Michigan Board of Land Surveyors or by a Decree of a Court of Law; established, re-established, monumented, re-monumented, recovered, found as expressed below:

NOTE: Not more than 4 corners, all in the same town and range, may be recorded on this certificate.

A. Description of original monument and accessories and/or subsequent restoration:
 Original Survey South Bdy. T16NR11E, 1835, Harvey Parke, D.S.

L-13 South ¼ Corner of Section 36
 Post
 Cedar 8", N74½°E, 9 links
 Cedar 7", N34½°W, 8 links
 County surveyors record: iron rod
 Recorded surveys: L4, P12
 LCRC: none

M-13 Corner of Townships 15 and 16 North, Ranges 11 and 12 East
 Post
 Beech 17", N17°E, 15 links
 Beech 17", S30°W, 18 links
 County surveyors record: none
 Recorded surveys: L4, P12
 LCRC: none

B. Description of corner evidence found and/or method applied in restoring or reestablishing corner:

L-13 South ¼ Corner of Section 36
 Found ½" iron w/cap #15399
 AT centerline of Kilmanagh Rd.
 Accepted as the best available evidence of original corner position

M-13 Corner of Townships 15 and 16 North, Ranges 11 and 12 East
 Found iron in rock collar, 3' deep
 At intersection of Kilmanagh Rd. and Grassmere Rd.
 Accepted as the best available evidence of original corner position


C. Description of monument for corner and accessories established to perpetuate locating the position of the corner:

L-13 South ¼ Corner of Section 36
 ½" iron w/cap #15399, 3" below grd.
 From which:
 Tag in 12" cottonwood bears N1°W, 31.3'
 Tag in 9" poplar bears S41°E, 39.4'
 Tag in power pole bears S29°W, 57.2'
 ½" iron, flush w/grd. bears West, 15.25'

M-13 Corner of Townships 15 and 16 North, Ranges 11 and 12 East
 Set ½" iron w/cap # 39089 over iron
 From which:
 Road sign post bears N62°E, 35.7'
 ½" iron flush w/grd. bears S45°E, 30.0'
 Tag in PP bears S47°W, 71.5'
 Gas line sign post bears N50°W, 51.85'

Surveyed by James T. Meek
 Surveyor's Michigan License No. 39089

Date _____

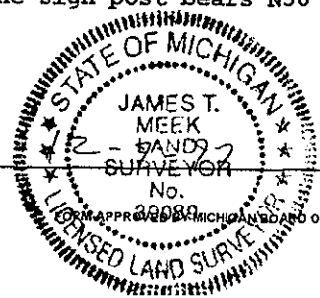

PROVED AT PEER BOARD MEETING, Nov. 25, 1997 RLB