

SURVEY & REMONUMENTATION

JAN 22 1998

Re-Mon Liber 1 Page 144

SECTION

1997 REMONUMENTATION

LAND CORNER RECORDATION CERTIFICATE
Filing Requirement of Act 74, Mich. P.A. 1970

For corners in COLFAX TOWNSHIP

<u>HURON</u> (County)	Located In:	Corner Code #
1. Public Land Survey	<u>T16N R 12E</u>	<u>B-13</u>
	T <u> </u> R <u> </u>	<u> </u>
	T <u> </u> R <u> </u>	<u> </u>
	T <u> </u> R <u> </u>	<u> </u>
2. Property Controlling in Section	S <u> </u> T <u> </u> R <u> </u>	<u> </u>
	S <u> </u> T <u> </u> R <u> </u>	<u> </u>
3. Miscellaneous Property in Sec.	S <u> </u> T <u> </u> R <u> </u>	<u> </u>
	S <u> </u> T <u> </u> R <u> </u>	<u> </u>

STATE OF MICHIGAN
HURON COUNTY
RECORDED

12 DEC 97 12:42 P.M.

FRANCES L. HOLDWICK
REGISTER OF DEEDS

Register of Deeds Stamp & File Number

4. Lot No. _____, Recorded Plat _____
5. Private Claims _____

I, Russell L. Brown, in a field survey on Nov. 24 19 97 do hereby state that under requirements of P.A. 74, Michigan P.A. of 1970, the corner points mentioned in lines 1 and 2 above were in conformance with regulations and rules therefore as required in the current manual of survey instructions of the United States Department of the Interior, Bureau of Land Management or by a decree of a Court of Law and /or that the corner points mentioned in lines 3, 4 and 5 above were in conformance with the rules of the Michigan Board of Land Surveyors or by a Decree of a Court of Law, established, re-established, monumented, recovered, found as expressed below:

NOTE: Not more than 2 corners, all in the same town and range, may be recorded on this certificate.

1	A	B	C	D	E	F	G	H	I	J	K	L	M
2		6		5		4		3		2		1	
3													
4		7		8		9		10		11		12	
5													
6		10		17		16		15		14		13	
7													
8		19		20		21		22		23		24	
9													
10		30		29		28		27		26		25	
11													
12		31		32		33		34		35		36	
13													

A. Description of original monument and accessories and/or subsequent restoration:


1834 G.L.O. H. Parke D.S. Set quarter section post.
Beech 10 N57E 28, Beech 15 N52W 28
COUNTY SURVEYORS RECORDS: None
COUNTY ROAD COMMISSION RECORDS: Ford Axle (app.) 18" Poplar, S3°W 34.9', 10" Maple N22"E 29.8', 12" Pine N55°E 45.7'
ACT 74 FORM: None
RECORDED SURVEYS: None

B. Description of corner evidence found and/or method applied in restoring or reestablishing corner:

No evidence of original corner position found.
No evidence of Axle Shaft or accessories cited in Road Commission records found.
Set 1/2" X 18" Steel Stake on Southerly extension of existing fenceline to North at intersection of line between A-13 (Southwest Corner Section 31, T16N-R12E) and C-13 (Southeast Corner Section 31, T16N-R12E,) as best evidence of original corner position.

C. Description of monument for corner and accessories established to perpetuate locating the position of the corner:

B-13 S. 1/4 Corner Section 31, T16N-R12E
Set 1/2" x 18" Steel Stake capped 24588
WITNESSES:
N10°E 36.85' to P.K. Nail in S.E. Corner Railroad Tie Post
S50°E 75.14' to Spike in N.E. Side 8" Pine
S60°W 128.56' to Spike in S.E. Side P.P.
N60°W 69.80' to R.R.S. in S.W. Side 20" Pine
East 2585.74' to Southeast Corner Section 31, T16N-R12E, C-13
West 2899.63' to Southwest Corner Section 31, T16N-R12E, A-13

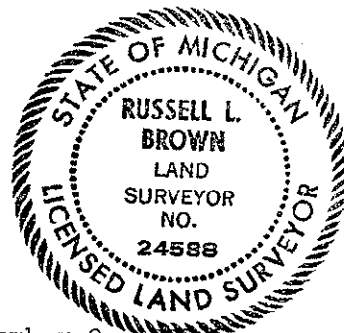

Signed by Russell L. Brown
Surveyor's Michigan License No. 24588

Date December 9, 1997

PEER GROUP APPROVED

AT MEETING HELD

DEC 11, 1997.
PIR