

SURVEY & REMONUMENTATION

JAN 22 1998

SECTION

Re-Mon Liber 1 Page 142

1997 REMONUMENTATION

LAND CORNER RECORDATION CERTIFICATE
Filing Requirement of Act 74, Mich. P.A. 1970

For corners in COLFAX TOWNSHIP

<u>HURON</u> (County)	Located In:	Corner Code #
1. Public Land Survey	T <u>16</u> N R <u>12</u> E	<u>D-13</u>
	T ___ R ___	_____
	T ___ R ___	_____
	T ___ R ___	_____
2. Property Controlling in Section	S ___ T ___ R ___	_____
	S ___ T ___ R ___	_____
3. Miscellaneous Property in Sec.	S ___ T ___ R ___	_____
	S ___ T ___ R ___	_____

STATE OF MICHIGAN
HURON COUNTY
RECORDED

12 DEC 97 12:41 P.M.

FRANCES L. HOLDWICK
REGISTER OF DEEDS

Register of Deeds Stamp & File Number

4. Lot No. _____, Recorded Plat _____
5. Private Claims _____

I, Russell L. Brown, in a field survey on Nov. 24, 19 97 do hereby state that under requirements of P.A. 74, Michigan P.A. of 1970, the corner points mentioned in lines 1 and 2 above were in conformance with regulations and rules therefore as required in the current manual of survey instructions of the United States Department of the Interior, Bureau of Land Management or by a decree of a Court of Law and/or that the corner points mentioned in lines 3, 4 and 5 above were in conformance with the rules of the Michigan Board of Land Surveyors or by a Decree of a Court of Law; established, re-established, monumented, recovered, found as expressed below:


NOTE: Not more than 2 corners, all in the same town and range, may be recorded on this certificate.

	A	B	C	D	E	F	G	H	I	J	K	L	M
1													
2		6		5		4		3		2		1	
3													
4		7		8		9		10		11		12	
5													
6		18		17		16		15		14		13	
7													
8		19		20		21		22		23		24	
9													
10		30		29		28		27		26		25	
11													
12		31		32		33		34		35		36	
13													

A. Description of original monument and accessories and/or subsequent restoration:
1834 G.L.O. H. Parke D.S., Set quarter section Post Hemlock 10 N51 1/2W 41, Hemlock 15 N54E 81
COUNTY SURVEYORS RECORDS: April 23, 1879 William Anderson, Deputy County Surveyor.
South 1/4 Stake, Hemlock N51 1/2W 41 Lks., Hemlock Root N54E 1 Lk.
COUNTY ROAD COMMISSION RECORDS: None
ACT 74 FORM: None
RECORDED SURVEYS: May 17, 1978 survey by S.G. Case P.S. 15399,
Found 1" Steel Pipe in place, WITNESSES: 1/2" Steel pin, South 28.87', 1/2" Steel Pin North 30.25', End 12" C.M.P. S65°W 59.0'

B. Description of corner evidence found and/or method applied in restoring or reestablishing corner:
No evidence of original corner or accessories found.
Found 1" Pipe
Accepted found 1" Pipe as best evidence of original corner position.

C. Description of monument for corner and accessories established to perpetuate locating the position of the corner:
D-13 South 1/4 Corner Section 32, T16N-R12E
Found 1" Pipe
WITNESSES:
N45°W 25.98' to 1/2" x 18" Steel Stake
N45°E 23.80' to 1/2" x 18" Steel Stake
S45°E 24.30' to 1/2" x 18" Steel Stake
S40°W 84.20' to Nail in E. Side 8" Twin Elm
West 52.51' to 2" Pinched Pipe apparent North 1/4 Corner Section 5, T15N-R12E
East 2674.78' to Corner Sections 32 and 33, T16N-R12E, E-13
West 2674.87' to Corner Sections 31 and 32, T16N-R12E, C-13

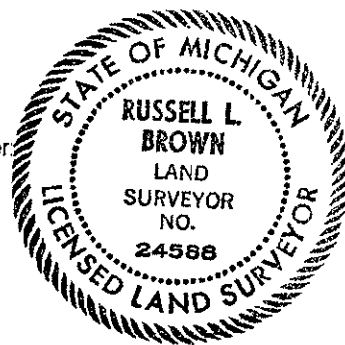

Signed by Russell L. Brown Date December 9, 1997

Surveyor's Michigan License No. 24588

PEER GROUP APPROVED
AT MEETING HELD

DEC 11, 1997.

RLB