

SURVEY & REMONUMENTATION

JAN 22 1998

Re-Mon Liber 1 Page 140

SECTION

1997 REMONUMENTATION

LAND CORNER RECORDATION CERTIFICATE
Filing Requirement of Act 74, Mich. P.A. 1970

STATE OF MICHIGAN
HURON COUNTY
RECORDED

12 DEC 97 12:41 P.M.

FRANCES L. HOLDNICK
REGISTER OF DEEDS

Register of Deeds Stamp & File Number

For corners in COLFAX TOWNSHIP

<u>HURON</u> (County)	Located In:	Corner Code #
1. Public Land Survey	T <u>16NR 12E</u>	<u>F-13</u>
	T <u> R</u>	<u> </u>
	T <u> R</u>	<u> </u>
	T <u> R</u>	<u> </u>
2. Property Controlling in Section	S <u> </u> T <u> R</u>	<u> </u>
	S <u> </u> T <u> R</u>	<u> </u>
3. Miscellaneous Property in Sec.	S <u> </u> T <u> R</u>	<u> </u>
	S <u> </u> T <u> R</u>	<u> </u>

4. Lot No. _____, Recorded Plat _____
5. Private Claims _____

I, Russell L. Brown, in a field survey on Nov. 24, 19 97 do hereby state that under requirements of P.A. 74, Michigan P.A. of 1970, the corner points mentioned in lines 1 and 2 above were in conformance with regulations and rules therefore as required in the current manual of survey instructions of the United States Department of the Interior, Bureau of Land Management or by a decree of a Court of Law and/or that the corner points mentioned in lines 3, 4 and 5 above were in conformance with the rules of the Michigan Board of Land Surveyors or by a Decree of a Court of Law; established, re-established, monumented, recovered, found as expressed below:

NOTE: Not more than 2 corners, all in the same town and range, may be recorded on this certificate.

	A	B	C	D	E	F	G	H	I	J	K	L	M
1													
2		6		5		4		3		2		1	
3													
4		7		8		9		10		11		12	
5													
6		18		17		16		15		14		13	
7													
8		19		20		21		22		23		24	
9													
10		30		29		28		27		26		25	
11													
12		31		32		33		34		35		36	
13													

A. Description of original monument and accessories and/or subsequent restoration:
1834 G.L.O. H. Parke D.S. Set quarter Section Post
Birch 28 N42W 9, Beech 6 N69E 26 1/2
COUNTY SURVEYORS RECORDS: None
COUNTY ROAD COMMISSION RECORDS: None
ACT 74 FORM: None
RECORDED SURVEYS: None

B. Description of corner evidence found and/or method applied in restoring or reestablishing corner:
No evidence of original corner or accessories found.

Set 1/2" x 18" Steel Stake capped 24588 by single proportionate measurement between G-13 (Corner Section 33 and 34, T16N-R12E) and E-13 (Corner Sections 32 and 33, T16N-R12E) as best evidence of original corner position.

C. Description of monument for corner and accessories established to perpetuate locating the position of the corner:

F-13 South 1/4 Corner Section 33, T16N-R12E
Set 1/2" x 18" Steel Stake capped 24588


WITNESSES:

N40°E 53.90' to P.K. Nail in N.W. Side P.P.
S20°W 54.98' to Spike in E. Side 12" Twin Elm
N70°W 59.26' to 1/2" x 18" Steel Stake
S70°E 51.00' to 1/2" x 18" Steel Stake

West 15.01' to 1/2" x 18" Steel Stake over 5/8" Re-Rod apparent N. 1/4 Corner of Section 4, T15N-R12E

East 2625.46' to Southeast Corner Section 33, T16N-R12E, G-13

West 2625.46' to Southwest Corner Section 33, T16N-R12E, E-13

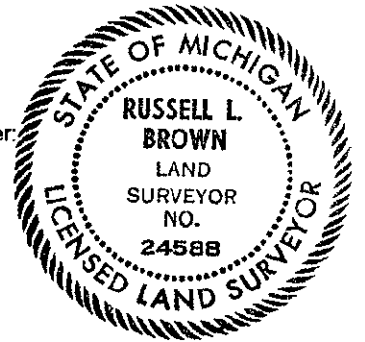

Signed by Russell L. Brown Date December 9, 1997

Surveyor's Michigan License No. 24588

PEER GROUP APPROVED

AT MEETING HELD

DEC 11, 1997.

RLB