

SURVEY & REMONUMENTATION

JAN 22 1998

Re-Mon Liber 1 Page 138

1997 REMONUMENTATION

SECTION

LAND CORNER RECORDATION CERTIFICATE
Filing Requirement of Act 74, Mich. P.A. 1970

For corners in COLFAX TOWNSHIP

HURON (County)	Located In:	Corner Code #
	T16N R 12E	H-13
	T R	
	T R	
	T R	
	T R	
1. Public Land Survey		
2. Property Controlling in Section	S T R	
3. Miscellaneous Property in Sec.	S T R	
	S T R	
	S T R	

STATE OF MICHIGAN
HURON COUNTY
RECORDED

12 DEC 97 12:41 P.M.

FRANCES L. HOLDWICK
REGISTER OF DEEDS

Register of Deeds Stamp & File Number

4. Lot No. _____, Recorded Plat _____
5. Private Claims _____

I, Russell L. Brown, in a field survey on Nov. 24, 19 97 do hereby state that under requirements of P.A. 74, Michigan P.A. of 1970, the corner points mentioned in lines 1 and 2 above were in conformance with regulations and rules therefore as required in the current manual of survey instructions of the United States Department of the Interior, Bureau of Land Management or by a decree of a Court of Law and /or that the corner points mentioned in lines 3, 4 and 5 above were in conformance with the rules of the Michigan Board of Land Surveyors or by a Decree of a Court of Law; established, re-established, monumented, recovered, found as expressed below:


	A	B	C	D	E	F	G	H	I	J	K	L	M
1													
2	6		5		4		3		2		1		
3													
4	7		8		9		10		11		12		
5													
6	10		17		16		15		14		13		
7													
8	19		20		21		22		23		24		
9													
10	30		29		28		27		26		25		
11													
12	31		32		33		34		35		36		
13													

NOTE: Not more than 2 corners, all in the same town and range, may be recorded on this certificate.

A. Description of original monument and accessories and/or subsequent restoration:
1834 G.L.O. H. Parke D.S., Set quarter Section Post
Birch 11 N51 1/2W 10, Cedar 8 N80E 24
COUNTY SURVEYORS RECORDS: 1888 survey by Duncan McFadden, County Surveyor, Survey of part of Section 34, T16N-R12E, Corner reestablished from witness trees. No object or accessories given.
COUNTY ROAD COMMISSION RECORDS: None
ACT 74 FORM: None
RECORDED SURVEYS: None

B. Description of corner evidence found and/or method applied in restoring or reestablishing corner:
No evidence of original corner or accessories found.
Found 1/2" Dia. Steel Stake
Accepted Found 1/2" Dia. Steel Stake as best evidence of original corner position.

C. Description of monument for corner and accessories established to perpetuate locating the position of the corner:
H-13 S. 1/4 Corner Section 34, T16N-R12E
Found 1/2" Dia. Steel Stake, Capped 24588
WITNESSES:
N50°E 95.11' to P.K. Nail in N.W. Side P.P.
S60°E 117.32' to Nail in N. Side P.P.
S60°W 48.74' to 1/2" x 18" Steel Stake
N60°W 40.29' to 1/2" x 18" Steel Stake
East 2633.01' to S.E. Corner Section 34, T16N-R12E, I-13
West 2632.47' to S.W. Corner Section 34, T16N-R12E, G-13

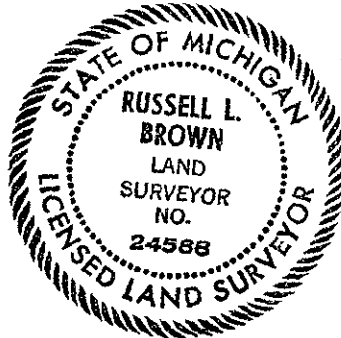

Signed by Russell L. Brown
Surveyor's Michigan License No. 24588

Date December 9, 1997

PEER GROUP APPROVED
AT MEETING HELD
DEC. 11, 1997.
RLB