

Re-Mon Lebu 1, Page 209

**1998 REMONUMENTATION
 LAND CORNER RECORDATION CERTIFICATE
 Filing Requirement of Act 74, Mich. P.A. 1970**

For Corners in COLFAX Township

Huron (County) Located in: Corner Code #

1. Public Land Survey T 16N R 12E M-1
 T ----- R -----
 T ----- R -----
 T ----- R -----
 2. Property Controlling S ----- T ----- R -----
 in Section S ----- T ----- R -----
 3. Miscellaneous S ----- T ----- R -----
 Property in Sec. S ----- T ----- R -----

**SURVEY &
 REMONUMENTATION**

JAN 28 1999

SECTION

STATE OF MICHIGAN
 HURON COUNTY
 RECORDED

15 DEC 98 3:30 P.M.

FRANCES L. HOLDWICK
 REGISTER OF DEEDS

Register of Deeds Stamp & File Number

4. Lot No. _____, Recorded Plat _____
 5. Private Claims _____

A	B	C	D	E	F	G	H	I	J	K	L	M
2	6		5		4		3		2		1	
3												
4	7		8		9		10		11		12	
5												
6	18		17		16		15		14		13	
7												
8	19		20		21		22		23		24	
9												
10	30		29		28		27		26		25	
11												
12	31		32		33		34		35		36	
13												

I, Russell L. Brown, in a field survey on July 24, 1998 do hereby state that under requirements of P.A. 74, Michigan P.A. of 1970, the corner points mentioned in lines 1 and 2 above were in conformance with regulations and rules therefore as required in the current manual of survey instructions of the United States Department of the Interior, Bureau of Land Management or by a decree of a Court of Law and/or that the corner points mentioned in lines 3, 4, and 5 above were in conformance with the rules of the Michigan Board of Land Surveyors or by a Decree of a Court of Law; established, re-established, monumented, recovered, found as expressed below:


NOTE: Not more than 2 corners, all in the same town and range, may be recorded on this certificate.

A. Description of original monument and accessories and/or subsequent restoration:
 1834 G.L.O. H. Parke D.S. Set as A-13, T17N-R13E; B. Ash 13 S43E 2, Cedar 17 S82W 7
 County Surveyors Records: NONE
 County Road Commission Records: Monument Box . 3" Cal. Maple N89°E 58.22'; 8" Cal. Maple S45°E 42.55'
 Recorded Surveys: Over
 Unrecorded Surveys: NONE

B. Description of corner evidence found and/or method applied in restoring or reestablishing corner:
 No evidence of original corner or accessories.

Found 1" Steel Bar in Monument Box

Accepted found 1" Steel Bar in Monument Box as best evidence of original corner position.

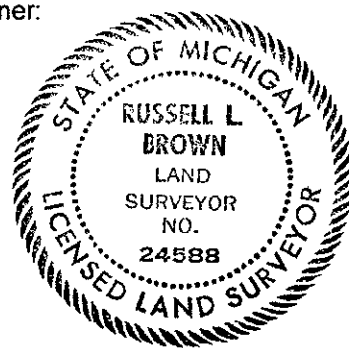

C. Description of monument for corner and accessories established to perpetuate locating the position of the corner:

M-1, Northeast Corner Section 1, T16N-R12E
 Found 1" Steel Bar in Monument Box
 WITNESSES:
 N45°W 57.02' set 1/2" Steel Stake at Southeast Corner Concrete Pad Ped. Base
 N45°E 50.40' Set 1/2" Steel Stake
 S65°W 75.50' found Form Nail & MDOT Tag in Northwest side Power Pole
 S55°E 90.60' found Form Nail & MDOT Tag in Northeast Side Power Pole
 East 6.90' to centerline State Trunkline M-53
 East 2484.06' to B-13, South 1/4 Corner Section 31, T17N-R13E
 West 2646.31' to L-13, South 1/4 Corner Section 36, T17N-R12E

NOTE:
 This corner is common with
 M-13, T17N-R12E
 A-13, T17N-R13E
 A-1, T16N-R13E

Signed by Russell L. Brown Date DEC. 7, 1998
 Surveyor's Michigan License No. 24588

Peer group approved at meeting held December 8, 1998. *R.L.B.*

Liber 1, Page 209 A

Recorded Surveys M-1 Colfax

October 10, 1974, Liber 2 page 238, by Stewart G. Case P.S. 15399

Southeast Corner Section 36, T17N-R12E, Meade Township, Monument Box 5.0' West of centerline of Highway M-53.

No Witnesses given

March 28, 1979, Liber 3, Page 715, by Stewart G. Case P.S. 15399

Northeast Corner Fractional Section 1, T16N-R12E, 1" Steel Shaft in place in Monument Box approximately 5.0' West of centerline of Highway right of way.

No Witnesses given

Liber 3, Page 760, by Stewart G. Case P.S. 15399

Northeast Corner Fractional Section 1, T16N-R12E, 1" Steel Shaft in place in Monument Box Approximately 5.0' West of centerline of Highway right of way

No Witnesses given

\$ 9.00 SURVEY
\$ 2.00 MSSR

**SURVEY &
REMONUMENTATION**

JAN 28 1999

SECTION