

**SURVEY & REMONUMENTATION**

JAN 22 1998

*Re-Monumentation, Page 87*  
1997 REMONUMENTATION

**SECTION**

**LAND CORNER RECORDATION CERTIFICATE**  
Filing Requirement of Act 74, Mich. P.A. 1970

For corners in VERONA TOWNSHIP

<u>HURON</u> (County)	Located In:	Corner Code #
1. Public Land Survey	T <u>16</u> N R <u>13</u> E	<u>C-13</u>
	T ___ R ___	_____
	T ___ R ___	_____
	T ___ R ___	_____
2. Property Controlling in Section	S ___ T ___ R ___	_____
	S ___ T ___ R ___	_____
3. Miscellaneous Property in Sec.	S ___ T ___ R ___	_____
	S ___ T ___ R ___	_____

STATE OF MICHIGAN  
HURON COUNTY  
RECORDED  
1 DEC 97 1:50 P.M.  
FRANCES L. HOLDWICK  
REGISTER OF DEEDS  
Register of Deeds Stamp & File Number

4. Lot No. \_\_\_\_\_, Recorded Plat \_\_\_\_\_  
5. Private Claims \_\_\_\_\_

I, Russell L. Brown, in a field survey on Oct. 15, 1997 do hereby state that under requirements of P.A. 74, Michigan P.A. of 1970, the corner points mentioned in lines 1 and 2 above were in conformance with regulations and rules therefore as required in the current manual of survey instructions of the United States Department of the Interior, Bureau of Land Management or by a decree of a Court of Law and for that the corner points mentioned in lines 3, 4 and 5 above were in conformance with the rules of the Michigan Board of Land Surveyors or by a Decree of a Court of Law; established, re-established, monumented, recovered, found as expressed below:


	A	B	C	D	E	F	G	H	I	J	K	L	M
1													
2	6		5		4		3		2		1		
3													
4	7		8		9		10		11		12		
5													
6	18		17		16		15		14		13		
7													
8	19		20		21		22		23		24		
9													
10	30		29		28		27		26		25		
11													
12	31		32		33		34		35		36		
13													

NOTE: Not more than 2 corners, all in the same town and range, may be recorded on this certificate.

A. Description of original monument and accessories and/or subsequent restoration:  
1834 G.L.O. H. Parke D.S. Set Post Corner Sections 31 and 32  
Beech 10 N50E 34, Beech 8 N62W 30  
1895 COUNTY SURVEYORS RECORDS: Duncan McFadden County Surveyor  
Set post, established from the nearest known corners. No accessories.  
ACT 74 FORMS: None  
COUNTY ROAD COMMISSION RECORDS: Pointed Stone  
S40°W 60.7' to Spike 18" Elm, S50°E 52.0' Spike 3" Twin Elm  
RECORDED SURVEYS: None

B. Description of corner evidence found and/or method applied in restoring or reestablishing corner:  
No evidence of original corner or accessories found.  
Found 1/2" Dia. Re-rod in center of gravel road East and West (Popple Road) and center of gravel road North (Nugent Road).  
Accepted 1/2" Dia. Re-rod as the best evidence of original corner position.

C. Description of monument for corner and accessories established to perpetuate locating the position of the corner:  
Corners: Sections 31 and 32, T16N-R13E, C-13  
Found 1/2" Dia. Re-rod  
WITNESSES:  
S25°W 37.71' to 1/2" x 18" Steel Stake  
N45°W 52.02' to 1/2" x 18" Steel Stake  
West 49.42' to 5/8" Re-rod in Line Nugent Road to South  
N55°E 55.97' to Spike in Corner Post  
S40°E 39.34' to P.K. Nail in Power Pole  
East 2651.20' to South 1/4 Corner Section 32, T16N-R13E  
West 2649.89' to South 1/4 Corner Section 31, T16N-R13E

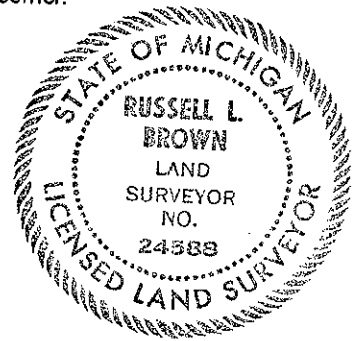

Signed by Russell L. Brown Date Nov. 3, 1997  
Surveyor's Michigan License No. 24588

PEER GROUP APPROVED  
AT MEETING HELD  
NOV 25, 1997. RLB