

SURVEY & REMONUMENTATION

JAN 22 1998

Re Mon. Liber 1, Page 91
1997 REMONUMENTATION

SECTION

LAND CORNER RECORDATION CERTIFICATE
Filing Requirement of Act 74, Mich. P.A. 1970

For corners in VERONA TOWNSHIP

HURON
(County)

Located In:

Corner Code #

1. Public Land Survey

T 16N R 13E G-13

T R

T R

T R

2. Property Controlling in Section

S T R

3. Miscellaneous Property in Sec.

S T R

S T R

S T R

4. Lot No. _____, Recorded Plat _____

5. Private Claims _____

STATE OF MICHIGAN
HURON COUNTY
RECORDED
1 DEC 97 1:51 P.M.
FRANCES L. HOLDWICK
REGISTER OF DEEDS
Register of Deeds Stamp & File Number

I, Russell L. Brown, in a field survey on Oct 16, 1997 do hereby state that under requirements of P.A. 74, Michigan P.A. of 1970, the corner points mentioned in lines 1 and 2 above were in conformance with regulations and rules therefore as required in the current manual of survey instructions of the United States Department of the Interior, Bureau of Land Management or by a decree of a Court of Law and for that the corner points mentioned in lines 3, 4 and 5 above were in conformance with the rules of the Michigan Board of Land Surveyors or by a Decree of a Court of Law; established, re-established, monumented, recovered, found as expressed below:

NOTE: Not more than 2 corners, all in the same town and range, may be recorded on this certificate.

	A	B	C	D	E	F	G	H	I	J	K	L	M
1													
2	6		5		4		3		2		1		
3													
4	7		8		9		10		11		12		
5													
6	18		17		16		15		14		13		
7													
8	19		20		21		22		23		24		
9													
10	30		29		28		27		26		25		
11													
12	31		32		33		34		35		36		
13													

A. Description of original monument and accessories and/or subsequent restoration:

1834 G.L.O. H. Parke D.S. Set Post Corner Section 33 and 34
Hemlock 24 N50 1/2W 19, Hemlock 11 N40W 43

COUNTY SURVEYOR RECORDS: None

ACT 74 FORMS: None

MDOT PLANS: (SEE OVER)

COUNTY ROAD COMMISSION RECORDS: Iron Pin

Corner Fence Post N32°W 39.36', Corner Fence Post S38°E 50.92'

Northeast Corner HDWLL S39°W 35.35', Power Pole N45°E 58.75'

RECORDED SURVEYS: None

B. Description of corner evidence found and/or method applied in restoring or reestablishing corner:

No evidence of original Corner or accessories found.

Found P.K. Nail, South of centerline gravel road East and West (Popple Road) and West of centerline asphalt road North and South (State Trunkline M-19).

Accepted P.K. Nail as the best evidence of original Corner position.

C. Description of monument for corner and accessories established to perpetuate locating the position of the corner:

Corners: Sections 33 and 34, T16N-R13E, G-13

Replaced P.K. Nail with 1/2" Re-rod capped 24588 in Monument Box in asphalt apron.

WITNESSES:

S45°W 60.83' to Nail & MDOT Tag in Southeast Side Power Pole

South 47.01' to 1/2" x 18" Steel Stake

N65°W 84.16' to 1/2" x 18" Steel Stake

N20°W 66.42' to 1/2" x 18" Steel Stake

East 88.37' to Bolt Spike apparent Corner Sections 3 and 4, T15N-R13E

East 22.40' to Centerline State Trunkline M-19.


East 2651.12' to South 1/4 Corner, Section 34, T16N-R13E

West 2639.54' to South 1/4 Corner, Section 33, T16N-R13E

Signed by Russell L. Brown

Surveyor's Michigan License No. 24588

Date Nov 3, 1997

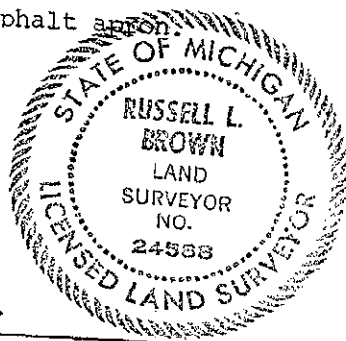

PEER GROUP APPROVED
AT MEETING HELD

Nov 25, 1997. RLB

Sheet 1, Page 91A

A. CONTINUED

MDOT PLANS: 7-18-1952

1 1/2" Iron Pipe in Cedar Post
Fence Post N30°00'W 39.84'
Corner HDWLL S16°00'E 26.36'
Power Pole S20°00'W 47.37'

\$ 9.00 SURVEY
\$ 2.00 MSSR