

Common to: M13 - Lincoln Twp. - T17N-R13E  
 A13 - Bloomfield Twp. - T17N-R14E  
 A01 - Sigel Twp. - T16N-R14E

*Re-Mon., Liber 1, Page 174*  
**REMONUMENTATION**

**LAND CORNER RECORDATION CERTIFICATE**  
 Filing Requirement of Act 74, Mich. P.A. 1970

For corners in

<u>Huron</u> (County)	Located In:	Corner Code #	
1. Public Land Survey	Verona	T <u>16</u> N R <u>13</u> E	M-1
		T ___ R ___	_____
		T ___ R ___	_____
		T ___ R ___	_____
2. Property Controlling in Section	S ___	T ___ R ___	_____
	S ___	T ___ R ___	_____
3. Miscellaneous Property in Sec.	S ___	T ___ R ___	_____
	S ___	T ___ R ___	_____

STATE OF MICHIGAN  
 HURON COUNTY  
 RECORDED

25 NOV 98 10:08 A.M.

FRANCES L. HOLIDWICK  
 REGISTER OF DEEDS

Register of Deeds Stamp & File Number

4. Lot No. \_\_\_\_\_, Recorded Plat \_\_\_\_\_  
 5. Private Claims \_\_\_\_\_

I, Charles S. Getz, in a field survey on Oct. 30, 1998 do hereby state that under requirements of P.A. 74, Michigan P.A. of 1970, the corner points mentioned in lines 1 and 2 above were in conformance with regulations and rules therefore as required in the current manual of survey instructions of the United States Department of the Interior, Bureau of Land Management or by a decree of a Court of Law and /or that the corner points mentioned in lines 3, 4 and 5 above were in conformance with the rules of the Michigan Board of Land Surveyors or by a Decree of a Court of Law; established, re-established, monumented, recovered, found as expressed below:

NOTE: Not more than 2 corners, all in the same town and range, may be recorded on this certificate.

	A	B	C	D	E	F	G	H	I	J	K	L	M
1													
2	6		5		4		3		2		1		
3													
4	7		8		9		10		11		12		
5													
6	18		17		16		15		14		13		
7													
8	19		20		21		22		23		24		
9													
10	30		29		28		27		26		25		
11													
12	31		32		33		34		35		36		
13													

A. Description of original monument and accessories and/or subsequent restoration:

M-1  
 1834 G.L.O., H. Parke D.S.  
 Post  
 Beech 10", S49°E, 11 Links  
 Hemlock 9", N31°W, 18 Links

County Surveyor Records - NONE  
 County Road Commission Records - Iron Pin  
 Recorded Surveys - Survey Liber 2, Page 375, 1 1/2" pipe in place.  
 Survey Liber 3, Page 217, 1 1/2" pipe  
 Survey Liber 3, Page 761, 1 1/2" Pipe over top of 3/4" steel pin in place.  
 Unrecorded Surveys - Case Surveying, 1-29-92, P.K. nail over corner  
 Case Surveying, 4-2-97, Fd. iron in place.  
 Huron Surveying, 6-29-93, Fd 3/4" Steel Stake

B. Description of corner evidence found and/or method applied in restoring or reestablishing corner:

M-1  
 NE Cor, Section 1, T16N-R13E  
 Found 1-1/4" Iron Pipe  
 Accepted as the best available evidence of original corner position  
 (Intersection of Rapson & Verona Roads)


SURVEY &  
 REMONUMENTATION

JAN 28 1999

SECTION

C. Description of monument for corner and accessories established to perpetuate locating the position of the corner:

M-1  
 NE Cor, Section 1, T16N-R13E  
 Set 1/2" Re-Rod in Monument Box (Capped)  
 N25°W 42.90' to Center of C.B.  
 S40°W 51.95' to Nail in Power Pole  
 S45°E 61.45' to Telephone Box  
 N45°E 69.90' to Corner of Building  
 West 2642.78' to S 1/4 Cor, Sec 36, T17N-R13E  
 East 2713.68' to S 1/4 Cor, Sec 31, T17N-R14E

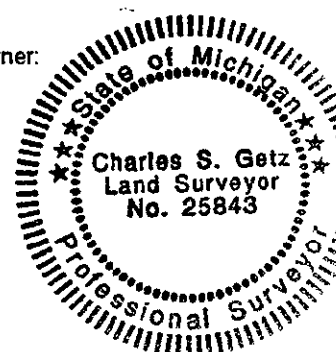

Signed by Charles S. Getz

Date October 31, 1998

Surveyor's Michigan License No. 25843

PEER GROUP APPROVED AT  
 MEETING 11-24-98 RAB