

SECTION

Re-Mon. Liber 1, Page 102

1997 REMONUMENTATION

LAND CORNER RECORDATION CERTIFICATE  
Filing Requirement of Act 74, Mich. P.A. 1970

For corners in SIGEL TOWNSHIP

<u>HURON</u> (County)	Located In:	Corner Code #
1. Public Land Survey	T <u>16</u> N R <u>14</u> E	C-13
	T ___ R ___	_____
	T ___ R ___	_____
	T ___ R ___	_____
2. Property Controlling in Section	S ___ T ___ R ___	_____
	S ___ T ___ R ___	_____
3. Miscellaneous Property in Sec.	S ___ T ___ R ___	_____
	S ___ T ___ R ___	_____

STATE OF MICHIGAN  
HURON COUNTY  
RECORDED  
1 DEC 97 1:59 P.M.  
FRANCES L. HOLDWICK  
REGISTER OF DEEDS  
Register of Deeds Stamp & File Number

4. Lot No. \_\_\_\_\_, Recorded Plat \_\_\_\_\_  
5. Private Claims \_\_\_\_\_

I, Russell L. Brown, in a field survey on Oct. 22, 19 97 do hereby state that under requirements of P.A. 74, Michigan P.A. of 1970, the corner points mentioned in lines 1 and 2 above were in conformance with regulations and rules therefore as required in the current manual of survey instructions of the United States Department of the Interior, Bureau of Land Management or by a decree of a Court of Law and/or that the corner points mentioned in lines 3, 4 and 5 above were in conformance with the rules of the Michigan Board of Land Surveyors or by a Decree of a Court of Law; established, re-established, monumented, recovered, found as expressed below:

NOTE: Not more than 2 corners, all in the same town and range, may be recorded on this certificate.

A	B	C	D	E	F	G	H	I	J	K	L	M
1												
2	6		5		4		3		2		1	
3												
4	7		8		9		10		11		12	
5												
6	18		17		16		15		14		13	
7												
8	19		20		21		22		23		24	
9												
10	30		29		28		27		26		25	
11												
12	31		32		33		34		35		36	
13												

A. Description of original monument and accessories and/or subsequent restoration:


1834 G.L.O. H. Parke D.S. Set Post Corner Section 31 and 32  
Sugar 9 N60W 29 1/2, Cedar 12 N83 1/2E 9 1/2  
COUNTY SURVEYOR RECORDS: None  
ACT 74 FORM: None  
COUNTY ROAD COMMISSION RECORDS: Iron Pin App  
Southwest, Base 16" Maple N45°E 32.2', Northwest, Base Con. Corner Post S45°E 48.2'  
RECORDED SURVEYS: None

B. Description of corner evidence found and/or method applied in restoring or reestablishing corner:

No evidence of original corner or accessories found.  
Set 1/2" x 18" Steel Stake 20.46' (0.31 G.L.O. Notes) East of apparent C-1; corner Sections 5 and 6, T15N-R14E as best evidence of original corner position.

C. Description of monument for corner and accessories established to perpetuate locating the position of the corner:

Corners: Sections 31 and 32, T16N-R14E, C-13  
Set 1/2" x 18" Steel Stake capped 24588  
WITNESSES:  
North 27.21' to Spike in West Side 28" Maple Tree  
N65°E 97.07' to Spike in Southerly Side 22" Maple Tree  
S25°E 33.91' to P.K. Nail in West Side Concrete Corner Post  
S55°W 100.85' to P.K. Nail in Northwest Side Power Pole  
West 20.46' to 1/2" Steel Stake apparent Corner Sections 5 and 6, T15N-R14E, C-1  
East 2653.45' to South 1/4 Corner Section 32, T16N-R14E, D-13  
West 2645.74' to South 1/4 Corner Section 31, T16N-R14E, B-13

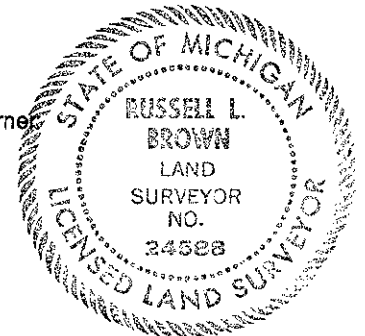

Signed by Russell L. Brown Date Nov. 3, 1997  
Surveyor's Michigan License No. 24588

PEER GROUP APPROVED  
AT MEETING HELD  
NOV. 25, 1997. RLB