

SURVEY & REMONUMENTATION

JAN 22 1998

Re-Monument, Page 103

1997 REMONUMENTATION

SECTION

LAND CORNER RECORDATION CERTIFICATE
Filing Requirement of Act 74, Mich. P.A. 1970

For corners in SIGEL TOWNSHIP

<u>HURON</u> (County)	Located in:	Corner Code #
1. Public Land Survey	T <u>16</u> N R <u>14</u> E	<u>D-13</u>
	T ___ R ___	_____
	T ___ R ___	_____
	T ___ R ___	_____
2. Property Controlling in Section	S ___ T ___ R ___	_____
	S ___ T ___ R ___	_____
3. Miscellaneous Property in Sec.	S ___ T ___ R ___	_____
	S ___ T ___ R ___	_____

STATE OF MICHIGAN
HURON COUNTY
RECORDED
1 DEC 97 1:59 P.M.
FRANCES L. HOLDWICK
REGISTER OF DEEDS

Register of Deeds Stamp & File Number

4. Lot No. _____, Recorded Plat _____
5. Private Claims _____

	A	B	C	D	E	F	G	H	I	J	K	L	M
1													
2	6			5		4		3		2		1	
3													
4	7			8		9		10		11		12	
5													
6	18			17		16		15		14		13	
7													
8	19			20		21		22		23		24	
9													
10	30			29		28		27		26		25	
11													
12	31			32		33		34		35		36	
13													

I, Russell L. Brown, in a field survey on Oct. 22, 1997 do hereby state that under requirements of P.A. 74, Michigan P.A. of 1970, the corner points mentioned in lines 1 and 2 above were in conformance with regulations and rules therefore as required in the current manual of survey instructions of the United States Department of the Interior, Bureau of Land Management or by a decree of a Court of Law and/or that the corner points mentioned in lines 3, 4 and 5 above were in conformance with the rules of the Michigan Board of Land Surveyors or by a Decree of a Court of Law; established, re-established, monumented, recovered, found as expressed below:

NOTE: Not more than 2 corners, all in the same town and range, may be recorded on this certificate.

A. Description of original monument and accessories and/or subsequent restoration:


1834 G.L.O. H. Parke D.S. Set quarter Section Post
Elm 14 N70 1/2W 16, B. Ash 5 N74E 3 1/2
COUNTY SURVEYOR RECORDS: None
ACT 74 FORM: None
COUNTY ROAD COMMISSION RECORDS: Iron Pin App.
16" Maple N45°E 32.2' Corner Post S45°E 48.2', Face Power Pole S60°E 80.8'
Face Power Pole N45°E 45.3', Face Fence Post N45°W 47.2'
RECORDED SURVEYS: , (OVER)

B. Description of corner evidence found and/or method applied in restoring or reestablishing corner:

No evidence of original corner or accessories found.
Set 1/2" x 18" Steel Stake by single proportionate measurement on line, between Corners C-13 and E-13, as best evidence of original corner position.

C. Description of monument for corner and accessories established to perpetuate locating the position of the corner:

South 1/4 Corner Section 32, T16N-R14E, D-13
Set 1/2" x 18" Steel Stake Capped 24588
WITNESSES:
S75°E 27.88' to 1/2" x 18" Steel Stake
N10°E 46.77' to Southwest Corner Concrete Water Tank
N45°W 31.69' to 1/2" x 18" Steel Stake
N65°E 40.52' to 1/2" x 18" Steel Stake
West 20.42' to 1/2" dia. Steel Stake. apparent D-1, North 1/4 Corner Section 5, T15N-R14E
East 2653.31' to Southeast Corner of Section 32, T16N-R14E
West 2653.31' to Southwest Corner of Section 32, T16N-R14E

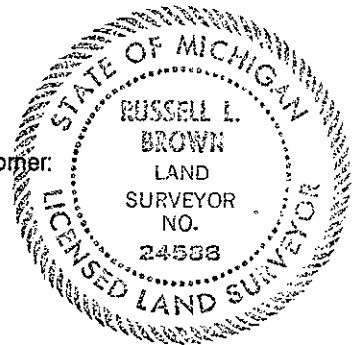

Signed by Russell L. Brown
Surveyor's Michigan License No. 24588

Date Nov. 3, 1997

PEER GROUP APPROVED
AT MEETING HELD
Nov 25, 1997. RLB

Liber 1, Page 103 A

A. CONTINUED

10-14-77 Survey Liber 3 of surveys on page 337 Huron County Records
by; Sanilac Land Surveying, Kay L.S. 14096

Found 1/2" Bar

WITNESSES:

North 33.0' to a 1/2" Bar

North 46.4' to a Well Casing

N50°E 47.0' to a Elm Stump

West 20.46' to a 1/2" Bar

10-12-78 Survey Liber 3 of Surveys on Page 655 Huron County Records
by; Sanilac Land Surveying, Millitics L.S. 25859

No object stated

WITNESSES:

North 33.0' to a 1/2" Bar

North 46.4' to a Well Casing

N50°E 47.0' to a Elm Stump

West 20.46' to a 1/2" Bar

\$ 9.00 SURVEY

\$ 2.00 MSSR