

SURVEY & REMONUMENTATION

JAN 22 1998

Re-Now Liber 1, Page 104

1997 REMONUMENTATION

SECTION

LAND CORNER RECORDATION CERTIFICATE
Filing Requirement of Act 74, Mich. P.A. 1970

For corners in SIGEL TOWNSHIP

HURON (County)	Located In:	Corner Code #
1. Public Land Survey	T <u>16N</u> R <u>14E</u>	<u>E-13</u>
	T ___ R ___	_____
	T ___ R ___	_____
	T ___ R ___	_____
2. Property Controlling in Section	S ___ T ___ R ___	_____
	S ___ T ___ R ___	_____
3. Miscellaneous Property in Sec.	S ___ T ___ R ___	_____
	S ___ T ___ R ___	_____

STATE OF MICHIGAN
HURON COUNTY
RECORDED

1 DEC 97 1:59 P.M.

FRANCES L. HOLDWICK
REGISTER OF DEEDS

Register of Deeds Stamp & File Number

4. Lot No. _____, Recorded Plat _____
5. Private Claims _____

I, Russell L. Brown, in a field survey on Oct. 21, 19 97 do hereby state that under requirements of P.A. 74, Michigan P.A. of 1970, the corner points mentioned in lines 1 and 2 above were in conformance with regulations and rules therefore as required in the current manual of survey instructions of the United States Department of the Interior, Bureau of Land Management or by a decree of a Court of Law and for that the corner points mentioned in lines 3, 4 and 5 above were in conformance with the rules of the Michigan Board of Land Surveyors or by a Decree of a Court of Law; established, re-established, monumented, recovered, found as expressed below:

NOTE: Not more than 2 corners, all in the same town and range, may be recorded on this certificate.

	A	B	C	D	E	F	G	H	I	J	K	L	M
1													
2		6		5		4		3		2		1	
3													
4		7		8		9		10		11		12	
5													
6		18		17		16		15		14		13	
7													
8		19		20		21		22		23		24	
9													
10		30		29		28		27		26		25	
11													
12		31		32		33		34		35		36	
13													

A. Description of original monument and accessories and/or subsequent restoration:


1834 G.L.O. H. Parke D.S. Set Post Corner Section 32 and 33
Pine 36 N67 1/2W 1 1/2, Maple 10 N42E 20
COUNTY SURVEYOR RECORDS: None
ACT 74 FORM: None
COUNTY ROAD COMMISSION RECORDS: None
RECORDED SURVEYS: (OVER)

B. Description of corner evidence found and/or method applied in restoring or reestablishing corner:

No evidence of original corner or accessories found.
Found 1/2" Dia. Steel Stake
Accepted 1/2" Dia. Steel Stake as the best evidence of original corner position.

C. Description of monument for corner and accessories established to perpetuate locating the position of the corner:

Corner Sections 32 and 33, T16N-R14E, E-13
Found 1/2" Dia. Steel Stake
WITNESSES:
West 20.46' to 1/2" Dia. Steel Stake, Apparent E-1, Corner Section 4 and 5, T15N-R14E
S10°E 36.90' to Bolt Hole in Top of 8' C.M.P.
S50°W 54.45' to Bolt Hole in Top of 8' C.M.P.
N50°E 100.64' to Spike in Northwest Side 38" Maple Tree
N45°W 107.05' to Spike in northeast Side 10" Ash Tree
East 2638.33' to South 1/4 Corner Section 33, T16N-R14E
West 2653.51' to South 1/4 Corner Section 32, T16N-R14E

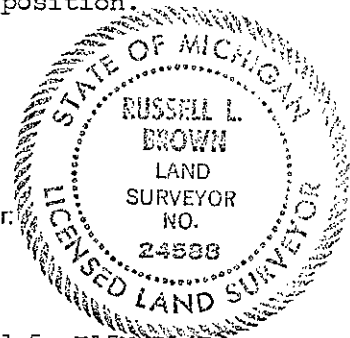

Signed by Russell L. Brown Date Nov. 3, 1997
Surveyor's Michigan License No. 24588

PEER GROUP APPROVED
AT MEETING HELD
NOV 25, 1997. RLB

Liber 1, Page 104A

A. CONTINUED

10-14-77 Survey recorded in Liber 3 of Surveys on Page 337 of Huron County Record.
By, Sanilac Land Surveying, Kay L.S. 14096

1/2" Bar

WITNESSES:

West 20.46' to a 1/2" Bar

S10°E 36.90' to a Bolt Hole Top of 8' C.M.P.

S50°W 54.45' to a Bolt Hole Top of 8' C.M.P.

10-12-78 Survey recorded in Liber 3 of Surveys on Page 655 of Huron County Records.
By; Sanilac Land Surveying, Milletics L.S. 25859

No object stated

WITNESSES:

West 20.46' to a 1/2" Bar

S10°E 36.90' to Bolt Hole Top of 8' C.M.P.

S50°W 54.45' to a Bolt Hole Top of 8' C.M.P.

\$ 9.00 SURVEY

\$ 2.00 MSSR