

**SURVEY &
REMONUMENTATION**

JAN 22 1998

Re Mon Relief, Page 110

1997 REMONUMENTATION

SECTION

LAND CORNER RECORDATION CERTIFICATE
Filing Requirement of Act 74, Mich. P.A. 1970

For corners in SIGEL TOWNSHIP

<u>HURON</u> (County)	Located In:	Corner Code #
1. Public Land Survey	T <u>16N</u> R <u>14E</u>	<u>K-13</u>
	T <u> </u> R <u> </u>	<u> </u>
	T <u> </u> R <u> </u>	<u> </u>
	T <u> </u> R <u> </u>	<u> </u>
2. Property Controlling in Section	S <u> </u> T <u> </u> R <u> </u>	<u> </u>
	S <u> </u> T <u> </u> R <u> </u>	<u> </u>
3. Miscellaneous Property in Sec.	S <u> </u> T <u> </u> R <u> </u>	<u> </u>
	S <u> </u> T <u> </u> R <u> </u>	<u> </u>

STATE OF MICHIGAN
HURON COUNTY
RECORDED

1 DEC 97 2:00 P.M.

FRANCES L. HOLDWICK
REGISTER OF DEEDS

Register of Deeds Stamp & File Number

4. Lot No. _____, Recorded Plat _____
5. Private Claims _____

I, Russell L. Brown, in a field survey on Oct. 20, 1997 do hereby state that under requirements of P.A. 74, Michigan P.A. of 1970, the corner points mentioned in lines 1 and 2 above were in conformance with regulations and rules therefore as required in the current manual of survey instructions of the United States Department of the Interior, Bureau of Land Management or by a decree of a Court of Law and/or that the corner points mentioned in lines 3, 4 and 5 above were in conformance with the rules of the Michigan Board of Land Surveyors or by a Decree of a Court of Law; established, re-established, monumented, recovered, found as expressed below:

NOTE: Not more than 2 corners, all in the same town and range, may be recorded on this certificate.

	A	B	C	D	E	F	G	H	I	J	K	L	M
1													
2		6		5		4		3		2		1	
3													
4		7		8		9		10		11		12	
5													
6		18		17		16		15		14		13	
7													
8		19		20		21		22		23		24	
9													
10		30		29		28		27		26		25	
11													
12		31		32		33		34		35		36	
13													

A. Description of original monument and accessories and/or subsequent restoration:

1834 G.L.O. H. Parke D.S. Set Post Corner Section 35 and 36
B. Ash 15 N46E 37 1/2, Cedar 6 N14 1/2W 6 1/2
COUNTY SURVEYOR RECORDS: None
ACT 74 FORM: None
COUNTY ROAD COMMISSION RECORDS: Pin in center of Old Pipe
Iron Pin Northwest 63.0', Iron Pin Northeast 73.0'
RECORDED SURVEYS: (OVER)

B. Description of corner evidence found and/or method applied in restoring or reestablishing corner:


No evidence of original corner or accessories found.

Found 3/4" Re-rod in Monument Box, in centerline asphalt Road East and West (Helena Road) and centerline gravel road North (Minden Road).

Accepted 3/4" Re-rod in Monument Box as the best evidence of original corner position.

C. Description of monument for corner and accessories established to perpetuate locating the position of the corner:

Corner Sections 35 and 36, T16N-R14E, K-13
Found 3/4" Re-rod in Monument Box
WITNESSES:
South 51.19' to P.K. Nail in West Side Power Pole
N35°W 67.92' to P.K. Nail in West Side Power Pole
N55°E 94.65' to P.K. Nail in Southeast Side Power Pole
S45°W 33.10' to 1/2" x 18" Steel Stake
West 75.12' 75.12' to Axle Shaft in Monument Box, apparent Corner K-1, T15N-R14E
East 2613.70' to South 1/4 Corner Section 36, T16N-R14E, L-13
West 2623.00' to South 1/4 Corner Section 35, T16N-R14E, J-13

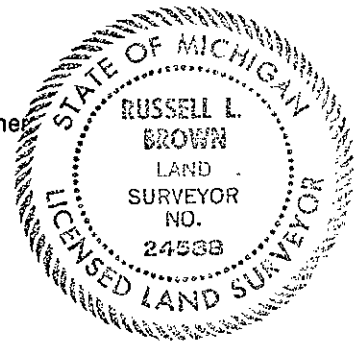

Signed by Russell L. Brown
Surveyor's Michigan License No. 24588

Date Nov. 3, 1997

PEER GROUP APPROVED
AT MEETING HELD

Nov 25, 1997 RLB

Letter 1, Page 110A

A. CONTINUED

March 6, 1997 unrecorded survey by Huron Surveying, Inc., Brown 24588
Found 3/4" Steel Stake in Monument Box

WITNESSES:

South 51.19' to P.K. Nail in West Side Power Pole
N45°W 67.92' to P.K. Nail in Southwest Side Power Pole
N55°E 94.70' to P.K. Nail in Southwest Side Power Pole

\$ 9.00 SURVEY
\$ 2.00 HSSR