

SURVEY & REMONUMENTATION

JAN 22 1998

Re Mon. Liber 1, Page 111

SECTION

1997 REMONUMENTATION LAND CORNER RECORDATION CERTIFICATE Filing Requirement of Act 74, Mich. P.A. 1970

For corners in SIGEL TOWNSHIP

Table with columns: HURON (County), Located in, Corner Code #. Rows include Public Land Survey, Property Controlling in Section, and Miscellaneous Property in Sec.

STATE OF MICHIGAN HURON COUNTY RECORDED 1 DEC 97 3:00 P.M. FRANCES L. HOLDWICK REGISTER OF DEEDS Register of Deeds Stamp & File Number

4. Lot No. , Recorded Plat 5. Private Claims

I, Russell L. Brown, in a field survey on Oct. 20, 1997 do hereby state that under requirements of P.A. 74, Michigan P.A. of 1970, the corner points mentioned in lines 1 and 2 above were in conformance with regulations and rules therefore as required in the current manual of survey instructions of the United States Department of the Interior, Bureau of Land Management or by a decree of a Court of Law and /or that the corner points mentioned in lines 3, 4 and 5 above were in conformance with the rules of the Michigan Board of Land Surveyors or by a Decree of a Court of Law; established, re-established, monumented, recovered, found as expressed below:

NOTE: Not more than 2 corners, all in the same town and range, may be recorded on this certificate.

Grid table with columns A-M and rows 1-13. Numbers 1-36 are placed in the grid cells.

A. Description of original monument and accessories and/or subsequent restoration:


1834 G.L.O. H. Parke D.S. Set quarter Section Post Cedar 18 N33 1/2W 7, Fir 6 N67E 13 COUNTY SURVEYOR RECORDS: None ACT 74 FORM: None COUNTY ROAD COMMISSION RECORDS: Iron Pin Iron Pin, North 50.0' in line with fence North RECORDED SURVEYS: (OVER)

B. Description of corner evidence found and/or method applied in restoring or reestablishing corner:

No evidence of original corner or accessories found. Found 3/4" Steel Stake in Monument Box, in centerline asphalt road. Accepted 3/4" Steel Stake in Monument Box as the best evidence of original corner position.

C. Description of monument for corner and accessories established to perpetuate locating the position of the corner:

South 1/4 Corner Section 36, T16N-R14E, L-13 Found 3/4" Steel Stake in Monument Box WITNESSES: N10°W 50.02' to P.K. Nail in East Side Wood Post S50°W 88.67' to P.K. Nail in Southeast Side Power Pole S05°E 18.82' to 1/2" Capped rebar N55°E 61.20' to 1/2" x 18" Steel Stake East 2605.32' to Southeast Corner Section 36, T16N-R14E West 2613.70' to Southwest Corner Section 36, T16N-R14E

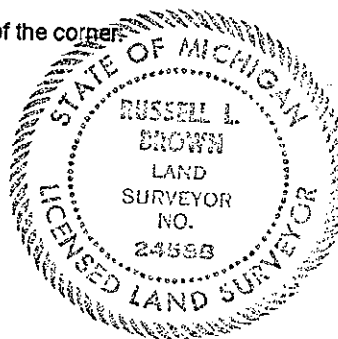

Signed by Russell L. Brown Date Nov 3, 1997 Surveyor's Michigan License No. 24588

PEER GROUP APPROVED AT MEETING HELD Nov 25, 1997. RLB

Leber 1, Page 111 A

A. CONTINUED

March 6, 1997 unrecorded survey by Huron Surveying, Inc., Brown P.S. 24588
Found 3/4" Steel Stake in Monument Box

WITNESSES:

N10°W 50.20' to P.K. Nail in East Side Wood Post

S50°W 88.67' to P.K. Nail in Southeast Side Power Pole

S05°E 18.82' to 1/2" Capped Steel Stake

\$ 9.00 SURVEY

\$ 2.00 MSSR