

**LAND CORNER RECORDATION CERTIFICATE**  
**Filing Requirement of Act 74, Mich. P.A. 1970**

For corners in

| <u>Huron</u><br><small>(County)</small> | Located In: | Corner Code #/ |
|---|-------------|----------------|
| 1. Public Land Survey                   | T 16N R 14E | E-13           |
|   | T 16N R 14E | F-13           |
|   | T 16N R 14E | G-13           |
| 2. Property Controlling<br>in Section   | S T R       |                |
|   | S T R       |                |
| 3. Miscellaneous<br>Property in Sec.    | S T R       |                |
|   | S T R       |                |

**Register of Deeds Stamp & File Number**

4. Lot No. \_\_\_\_\_, Recorded Plat \_\_\_\_\_  
 5. Private Claims \_\_\_\_\_

|    | A  | B  | C  | D  | E  | F  | G | H | I | J | K | L | M |
|----|----|----|----|----|----|----|---|---|---|---|---|---|---|
| 2  | 6  | 5  | 4  | 3  | 2  | 1  |   |   |   |   |   |   |   |
| 3  |    |    |    |    |    |    |   |   |   |   |   |   |   |
| 4  | 7  | 8  | 9  | 10 | 11 | 12 |   |   |   |   |   |   |   |
| 5  |    |    |    |    |    |    |   |   |   |   |   |   |   |
| 6  | 18 | 17 | 16 | 15 | 14 | 13 |   |   |   |   |   |   |   |
| 7  |    |    |    |    |    |    |   |   |   |   |   |   |   |
| 8  | 19 | 20 | 21 | 22 | 23 | 24 |   |   |   |   |   |   |   |
| 9  |    |    |    |    |    |    |   |   |   |   |   |   |   |
| 10 | 30 | 29 | 28 | 27 | 26 | 25 |   |   |   |   |   |   |   |
| 11 |    |    |    |    |    |    |   |   |   |   |   |   |   |
| 12 | 31 | 32 | 33 | 34 | 35 | 36 |   |   |   |   |   |   |   |
| 13 |    |    |    |    |    |    |   |   |   |   |   |   |   |

Donald L. Bissell in a field survey on January, 19 89  
do hereby certify that under requirements of P.A. 74, Michigan P.A. of 1970, the corner points mentioned in lines 1 and 2 above were in conformance with regulations and rules therefore as required in the current manual of survey instructions of the United States Department of the Interior, Bureau of Land Management or by a decree of a Court of Law and/or that the corner points mentioned in lines 3, 4 and 5 above were in conformance with the rules of the Michigan Board of Land Surveyors or by a Decree of a Court of Law; established, re-established, monumented, re-monumented, recovered, found as expressed below:

**NOTE: Not more than 4 corners, all in the same town and range, may be recorded on this certificate.**

A. Description of original monument and accessories and/or subsequent restoration:


B. Description of corner evidence found and/or method applied in restoring or reestablishing corner:

|   |  |
|---|--|
| <p><b>E-13</b><br/> SW Cor. Sec. 33, T16N, R14E<br/> Fd. 1/2" iron rod in inters. Helena<br/> and MacDonald Road North.</p> <p><b>G-13</b><br/> SE Cor. Sec. 33, T15N, R14E<br/> Fd. 1/2" iron rod in Helena Road from<br/> witness info. provided by Stewart G.<br/> Case RLS# 15399</p> | <p><b>F-13</b><br/> S 1/4 Cor. Sec. 33, T16N, R14E<br/> Fd. angle iron in Helena Road<br/> From witness Info Provided<br/> by Stewart G. Case RLS# 15399</p> |
|---|--|

C. Description of monument for corner and accessories established to perpetuate locating the position of the corner:

|   |  |
|---|--|
| <p><b>E-13</b><br/> N43°W - 118.33' - 12" Elm<br/> N63°E - 101.00' - Maple Clump<br/> N41°E - 88.63' - 10" Elm<br/> S12°E - 36.9' - E end 72" C.M.P.<br/> S54°W - 54.6' - W end 72" C.M.P.<br/> West - 20.48' - 1/2" iron rod<br/> NW Cor. Sec. 4</p> | <p><b>F-13</b><br/> North - 32.44' - 4" Cedar post<br/> South - 8.65' - 1/2" iron rod<br/> S75°W - 26.0 - 1/2" iron rod</p> <p><b>G-13</b><br/> N30°E - 79.15' - Power pole<br/> N65°E - 67.30' - Power Pole<br/> S05°W - 20.0' - Stop Sign Post</p> |
|---|--|

Signed by Donald L. Bissell  
Surveyor's Michigan License No. 18655

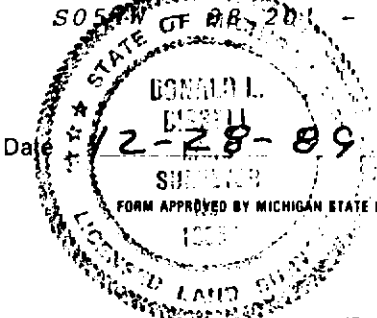

FORM APPROVED BY MICHIGAN STATE BOARD OF LAND SURVEYORS, JAN. 28, 1971  
 REVISED MAY 14, 1975  
 REVISED JAN., 1983