LAND CORNER RECORDATION CERTIFICATE Filing Requirement of Act 74, Mich. P.A. 1970

Ear	corners	in
roi	comers	111

Huron (County)		Located In:			Corner Code 44	
1.	Public Land Survey		T 16 N	R 14E	E-13	
			T 16 N	R <u>14</u> E	F-13	
			т 16 N	R <u>14E</u>	<u>G - 1 3</u>	
			Τ.	R		
2.	Property Controlling	S	T	R		
	in Section	S	T	R	=	
3.	Miscellaneous	S	_ T .	. R		
	Property in Sec.	S	, T	R		


Register of Deeds Stamp & File Number


4. Lot No , Recorded	Plat
----------------------	------

5. Private Claims .___ .

Donald L. Bissell in a field survey on January do hereby certify that under requirements of P.A. 74, Michigan P.A. of 1970, the corner points mentioned in lines 1 and 2 above were in conformance with regulations and rules therefore as required in the current manual of survey instructions of the United States Department of the Interior, Bureau of Land Management or by a decree of a Court of Law and/or that the corner points mentioned in lines 3, 4 and 5 above were in conformance with the rules of the Michigan Board of Land Surveyors or by a Decree of a Court of Law; established, re-established, monumented, re-monumented, recovered, found as expressed below:

NOTE: Not more than 4 corners, all in the same town and range, may be recorded on this certificate.

 

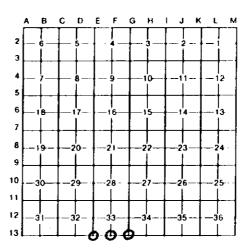

B. Description of corner evidence found and/or method applied in restoring or reestablishing corner:

E - 1.3SW Cor. Sec. 33, T16N, R14E Fd. 1/2" iron rod in inters. Helena and MacDonald Road North.

S 1/4 Cor. Sec.33, T16N, R14E Fd. angle iron in Helena Road From witness Info Provided by Stewart G. Case RLS# 15399

F-13

*

G-13

SE Cor. Sec. 33, T15N, R14E Fd. 1/2" iron rod in Helena Road from witness info. provided by Stewart G. Case RLS# 15399

C. Description of monument for corner and accessories established to perpetuate locating the position of the corner:

G - 1.3N65°E - 67.30' - Power Pole 805 W OF DB 201 - Stor 0500 OF 08 201 - Stop Sign Post

North - 32.44' - 4" Cedar post

South - 8.65' - 1/2" iron rod

S75°W - 26.0 - 1/2" iron rod

FUND (ALIO) FORM APPROVED BY MICHIGAN STATE BOARD OF LAND SURVEYORS, JAN. 28, 1971

Surveyor's Michigan License No.

REVISED MAY 14, 1975 REVISED JAN., 1983