

JAN 22 1998

SECTION

Re Man Liber 1, Page 77

REMONUMENTATION
LAND CORNER RECORDATION CERTIFICATE
Filing Requirement of Act 74, Mich. P.A. 1970

For corners in

Huron
(County)

Located in:

Corner Code #

- 1. Public Land Survey Sand Beach T16N R15E C-13
D-13
- 2. Property Controlling in Section S T R
- 3. Miscellaneous Property in Sec. S T R

STATE OF MICHIGAN
HURON COUNTY
RECORDED

6 NOV 97 10:25 A.M.

FRANCES L. HOLWICK
REGISTER OF DEEDS
Register of Deeds Stamp & File Number

- 4. Lot No. _____, Recorded Plat _____
- 5. Private Claims _____

I, Charles S. Getz, in a field survey on Aug. 17, 1997 do hereby state that under requirements of P.A. 74, Michigan P.A. of 1970, the corner points mentioned in lines 1 and 2 above were in conformance with regulations and rules therefore as required in the current manual of survey instructions of the United States Department of the Interior, Bureau of Land Management or by a decree of a Court of Law and /or that the corner points mentioned in lines 3, 4 and 5 above were in conformance with the rules of the Michigan Board of Land Surveyors or by a Decree of a Court of Law, established, re-established, monumented, recovered, found as expressed below:

	A	B	C	D	E	F	G	H	I	J	K	L	M
1													
2		6		5		4		3		2			1
3													
4		7		8		9		10		11			12
5													
6		18		17		16		15		14			13
7													
8		19		20		21		22		23			24
9													
10		30		29		28		27		26			25
11													
12		31		32		33		34		35			36
13													

NOTE: Not more than 2 corners, all in the same town and range, may be recorded on this certificate.

A. Description of original monument and accessories and/or subsequent restoration:

C-13 1834 G.L.O., H. Parke D.S.
Set Post
Hemlock 9", N55°W, 20 Links
Do. 7", N72°E, 25 Links

Co. Surveyor Records - NONE, Recorded Surveys - NONE
Co. Road Comm. Records - Cedar Post with 1" Iron Rod
Case Surveying 3-6-95 - Monument Box
L.C.R.C. - NONE

D-13 1834 G.L.O., H. Parke D.S.
Set quarter section post
B. Ash 10", N28°W, 22 Links
Maple 6", N48°E, 23 Links

Co. Surveyor Records - NONE, Recorded Surveys - NONE
Co. Rd. Comm. Records - Axle in Cedar Post
Huron Surveying 4-1-80 - 3/4" Re-Rod in Monument Box
L.C.R.C. - NONE

B. Description of corner evidence found and/or method applied in restoring or reestablishing corner:

C-13
SW Cor, Section 32, T16N-R15E
Found Bolt Spike in Monument Box
Accepted as the best available evidence of original corner position
(Intersection of Helena & Ruth Roads)

D-13
S 1/4 Cor, Section 32, T16N-R15E
Found 3/4" Re-Rod in Monument Box
Accepted as the best available evidence of original corner position

C. Description of monument for corner and accessories established to perpetuate locating the position of the corner:


C-13
SW Cor, Section 32, T16N-R15E
Found Bolt Spike in Monument Box
S20°E 62.25' to Nail in W. Side of Tele Pole
N50°E 84.46' to Nail in SE Side of Tele Pole
S45°W 117.30' to Nail in SE Side of Tele Pole
West 20.50' to Road Centerline
West 68.64' to PK Nail
West 2615.81' to S 1/4 Cor, Sec 31, T16N-R15E
East 2621.58' to S 1/4 Cor, Sec 32, T16N-R15E

D-13
S 1/4 Cor, Section 32, T16N-R15E
Found 3/4" Re-Rod in Monument Box
S20°E 37.24' to S. End of 60" CMP
N20°E 38.40' to N. End of 60" CMP
N40°W 111.55' to Nail in E. Side of Power Pole
West 2621.58' to SW Cor, Sec 32, T16N-R15E
East 2622.66' to SE Cor, Sec 32, T16N-R15E

Signed by Charles S. Getz
Surveyor's Michigan License No. 25843

Date October 12, 1997

PEER GROUP APPROVED AT
MEETING NOVEMBER 5, 1997.
RLB

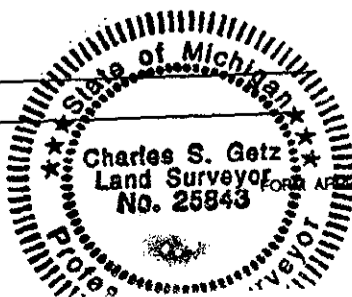

APPROVED BY MICHIGAN STATE BOARD OF PROFESSIONAL SURVEYORS, JAN. 28, 1971
REVISED MAY 14, 1975
REVISED JAN., 1983
REVISED OCT., 1985