

SURVEY & REMONUMENTATION

JAN 22 1998

SECTION

REMONUMENTATION *Re Mon Liber 1, Page 70*
LAND CORNER RECORDATION CERTIFICATE
 Filing Requirement of Act 74, Mich. P.A. 1970

For corners in

<u>Huron</u> (County)	Located In:	Corner Code #
1. Public Land Survey Sand Beach	T16N R15E	I-13 J-13
	T___ R___	_____
	T___ R___	_____
2. Property Controlling in Section	S___ T___ R___	_____
	S___ T___ R___	_____
3. Miscellaneous Property in Sec.	S___ T___ R___	_____
	S___ T___ R___	_____

STATE OF MICHIGAN
 HURON COUNTY
 RECORDED

6 NOV 97 10:25 A.M.

FRANCES L. HOLDWICK
 REGISTER OF DEEDS

Register of Deeds Stamp & File Number

4. Lot No. _____, Recorded Plat _____
 5. Private Claims _____

I, Charles S. Getz, in a field survey on Aug. 17, 1997 do hereby state that under requirements of P.A. 74, Michigan P.A. of 1970, the corner points mentioned in lines 1 and 2 above were in conformance with regulations and rules therefore as required in the current manual of survey instructions of the United States Department of the Interior, Bureau of Land Management or by a decree of a Court of Law and/or that the corner points mentioned in lines 3, 4 and 5 above were in conformance with the rules of the Michigan Board of Land Surveyors or by a Decree of a Court of Law; established, re-established, monumented, recovered, found as expressed below:

NOTE: Not more than 2 corners, all in the same town and range, may be recorded on this certificate.

1	A	B	C	D	E	F	G	H	I	J	K	L	M
2		6		5		4		3		2		1	
3													
4		7		8		9		10		11		12	
5													
6		10		17		16		15		14		13	
7													
8		19		20		21		22		23		24	
9													
10		30		29		28		27		26		25	
11													
12		31		32		33		34		35		36	
13													

A. Description of original monument and accessories and/or subsequent restoration:

I-13 1834 G.L.O., H. Parke D.S. Co. Surveyor Records - NONE, Co. Rd. Comm. Records - Axle
 Set Post Surveyor Liber 3, Page 669 - Monument Box
 Hemlock 9", N13°W, 8 Links Huron Surveying 10-7-96 - Monument Box
 Do. 7", N59°E, 15 Links L.C.R.C. - NONE

J-13 1834 G.L.O., H. Parke D.S. Co. Surveyor Records - NONE, Recorded Surveys - NONE
 Set quarter section post Co. Rd. Comm. Records - Pin in Post
 Hemlock 9", N65°E, 9 1/2 Links Unrecorded Surveys - NONE
 Do. 8", N43°W, 13 Links L.C.R.C. - NONE


B. Description of corner evidence found and/or method applied in restoring or reestablishing corner:

I-13 SW Cor, Section 35, T16N-R15E Found Axle Shaft in Monument Box Accepted as the best available evidence of original corner position (Intersection of Helena & Klug Roads)	J-13 S 1/4 Cor, Section 35, T16N-R15E Found 3/4" Iron Bar in Monument Box Accepted as the best available evidence of original corner position
---	--

C. Description of monument for corner and accessories established to perpetuate locating the position of the corner:

I-13 SW Cor, Section 35, T16N-R15E Found Axle Shaft in Monument Box West 13.55' to 3/4" Iron Bar in Monument Box N45°E 84.93' to Nail in NW Side of Power Pole N30°E 57.48' to Cable Post N45°W 54.20' to SE Cor of Tele Box S45°W 60.35' to NE Cor of Tele Box West 2636.84' to S 1/4 Cor, Sec 34, T16N-R15E East 2622.64' to S 1/4 Cor, Sec 35, T16N-R15E	J-13 S 1/4 Cor, Section 35, T16N-R15E Found 3/4" Iron Bar in Monument Box West 45.0' to 1" Iron Bar in Monument Box S45°W 61.18' to Nail in NW Side of Fence Post N70°W 109.18' to Nail in S. Side of Power Pole North 40.25' to Steel Fence Post West 2622.64' to SW Cor, Sec 35, T16N-R15E East 2586.72' to SE Cor, Sec 35, T16N-R15E
--	---

Signed by Charles S. Getz
 Surveyor's Michigan License No. 25843
 PEER GROUP APPROVED AT
 MEETING NOVEMBER 5, 1997.
RLB

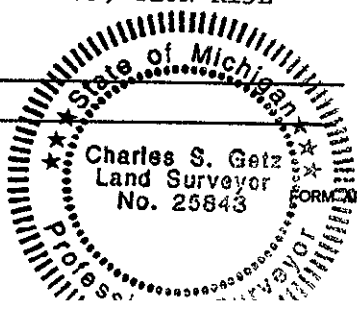

Date October 12, 1997