

JAN 19 2001

2000 REMONUMENTATION

Re New Litter 2, Page 60

SECTION

LAND CORNER RECORDATION CERTIFICATE  
Filing Requirement of Act 74, Mich. P.A. 1970

For corners in

<u>Huron</u> (County)	Located in:	Corner Code #
1. Public Land Survey Sand Beach	T16N R15E	A-6
	T ___ R ___	_____
	T ___ R ___	_____
	T ___ R ___	_____
2. Property Controlling in Section	S ___ T ___ R ___	_____
	S ___ T ___ R ___	_____
3. Miscellaneous Property in Sec.	S ___ T ___ R ___	_____
	S ___ T ___ R ___	_____

STATE OF MICHIGAN  
HURON COUNTY  
RECORDED

20 SEP 2000 2:02 PM

FRANCES L. HOLBICK  
REGISTER OF DEEDS

Register of Deeds Stamp & File Number


- 4. Lot No. \_\_\_\_\_, Recorded Plat \_\_\_\_\_
- 5. Private Claims \_\_\_\_\_

1	A	B	C	D	E	F	G	H	I	J	K	L
2		6		5		4		3		2		1
3												
4		7		8		9		10		11		12
5												
6		18		17		16		15		14		13
7												
8		19		20		21		22		23		24
9												
10		30		29		28		27		26		25
11												
12		31		32		33		34		35		36
13												

I, Charles S. Getz, in a field survey on May 17, 2000 do hereby state that under requirements of P.A. 74, Michigan P.A. of 1970, the corner points mentioned in lines 1 and 2 above were in conformance with regulations and rules therefore as required in the current manual of survey instructions of the United States Department of the Interior, Bureau of Land Management or by a decree of a Court of Law and /or that the corner points mentioned in lines 3, 4 and 5 above were in conformance with the rules of the Michigan Board of Land Surveyors or by a Decree of a Court of Law; established, re-established, monumented, recovered, found as expressed below:

NOTE: Not more than 2 corners, all in the same town and range, may be recorded on this certificate.

- A. Description of original monument and accessories and/or subsequent restoration:
  - A-6 1834 G.L.O., H. Parke D.S. County Road Commission Records - Iron Pin
  - Set quarter section post
  - B. Ash 16", S35°W, 35 Links Recorded Surveys - NONE
  - Beech 10", N52½°W, 9½ Links Unrecorded Surveys - NONE
  - L.C.R.C. - NONE
  - County Surveyor Records - NONE
- B. Description of corner evidence found and/or method applied in restoring or reestablishing corner:
  - A-6
  - W 1/4 Cor, Section 18, T16N-R15E
  - Found no evidence of original corner position
  - Re-established corner position by proportionate measure from G.L.O. Notes, between A-5 and A-7 as best evidence of original corner position for A-6. (On Finkel Road)
- C. Description of monument for corner and accessories established to perpetuate locating the position of the corner:
  - A-6
  - W 1/4 Cor, Section 18, T16N-R15E
  - Set 1/2" Re-Rod (Capped)
  - S70°E 35.00' to Northwest corner of 2.0' square Concrete Pillar
  - N45°W 82.30' to Nail in Large Power Pole
  - N55°W 75.50' to Nail in Large Power Pole
  - North 2627.85' to NW Cor, Sec 18, T16N-R15E
  - South 2627.85' to SW Cor, Sec 18, T16N-R15E

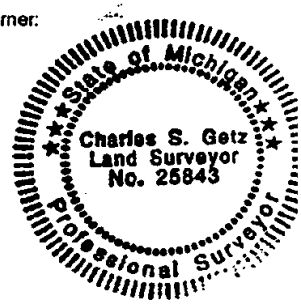

Signed by Charles S. Getz  
Surveyor's Michigan License No. 25843

Date June 10, 2000

PEER GROUP APPROVED AT MEETING  
HELD September 18, 2000. RLB