

\*Common to M13 - Sand Beach Twp. - T16N-R15E  
 \*Common to M01 - Sherman Twp. - T15N-R15E  
 \*Common to A01 - Sherman Twp. - T15N-R16E

**SURVEY & REMONUMENTATION**

JAN 22 1998

*Re-Mon Section 1, Page 73*

**REMONUMENTATION  
 LAND CORNER RECORDATION CERTIFICATE  
 Filing Requirement of Act 74, Mich. P.A. 1970**

For corners in

<u>Huron</u> (County)	Located In:	Corner Code #
1. Public Land Survey Sand Beach	T16N R16E	<u>A-13</u> B-13
	T R	
	T R	
	T R	
2. Property Controlling in Section	S T R	
	S T R	
3. Miscellaneous Property in Sec.	S T R	
	S T R	

STATE OF MICHIGAN  
 HURON COUNTY  
 RECORDED  
 6 NOV 97 10:26 A.M.  
 FRANCES L. HOLDWICK  
 REGISTER OF DEEDS  
 Register of Deeds Stamp & File Number

4. Lot No. \_\_\_\_\_, Recorded Plat \_\_\_\_\_  
 5. Private Claims \_\_\_\_\_

I, Charles S. Getz, in a field survey on Aug. 17, 1997 do hereby state that under requirements of P.A. 74, Michigan P.A. of 1970, the corner points mentioned in lines 1 and 2 above were in conformance with regulations and rules therefore as required in the current manual of survey instructions of the United States Department of the Interior, Bureau of Land Management or by a decree of a Court of Law and /or that the corner points mentioned in lines 3, 4 and 5 above were in conformance with the rules of the Michigan Board of Land Surveyors or by a Decree of a Court of Law; established, re-established, monumented, recovered, found as expressed below:

A	B	C	D	E	F	G	H	I	J	K	L	M
1												
2	6	5	4	3	2	1						
3												
4	7	8	9	10	11	12						
5												
6	18	17	16	15	14	13						
7												
8	19	20	21	22	23	24						
9												
10	30	29	28	27	26	25						
11												
12	31	32	33	34	35	36						
13												

NOTE: Not more than 2 corners, all in the same town and range, may be recorded on this certificate.

A. Description of original monument and accessories and/or subsequent restoration:

A-13 1834 G.L.O., H. Parke D.S. Post Hemlock 14", S28°W, 30 Links Do. 8", N31°E, 8 Links	County Surveyor Records - NONE, Unrecorded Surveys - NONE Co. Rd. Comm. Records - Pin in Post Survey Liber 3, Page 425 - 3/4" Re-Rod in Monument Box L.C.R.C. - NONE
B-13 1834 G.L.O., H. Parke D.S. Set quarter section post Hemlock 9", N61°W, 13 Links Do. 11", N34°E, 8 Links	Co. Surveyor Records - SEPT. 1865 Qr Stake, L.C.R.C. - NONE Co. Rd. Comm. Records - Axle, Unrecorded Surveys - NONE Survey Liber 3, Page 425 - Axle Shaft in Monument Box LAUGHLIN McDOWELL PLAT (Liber 3, Page 38) - shows corner

B. Description of corner evidence found and/or method applied in restoring or reestablishing corner:


A-13 SW Cor, Section 31, T16N-R16E Found 3/4" Re-Rod in Monument Box Accepted as the best available evidence of original corner position (Intersection of Helena & Edwards Roads)	B-13 S 1/4 Cor, Section 31, T16N-R16E Found Axle Shaft in Monument Box Accepted as the best available evidence of original corner position
---	---

C. Description of monument for corner and accessories established to perpetuate locating the position of the corner:

A-13 SW Cor, Section 31, T16N-R16E Found 3/4" Re-Rod in Monument Box N45°E 74.88' to Nail in SE Side of Power Pole S45°E 57.81' to Nail in NE Side of Cable Post N40°W 51.53' to S. Point of Conc. Project Marker West 2625.24' to S 1/4 Cor, Sec 36, T16N-R15E East 2623.54' to S 1/4 Cor, Sec 31, T16N-R16E	B-13 S 1/4 Cor, Section 31, T16N-R16E Found Axle Shaft in Monument Box North 35.26' to W. End of 18" CMP N45°E 56.62' to E. End of 18" CMP South 34.98' to E. End of 36" CMP S45°W 44.52' to W. End of 36" CMP West 2623.54' to SW Cor, Sec 31, T16N-R16E East 2623.70' to SE Cor, Sec 31, T16N-R16E
--	--

Signed by Charles S. Getz  
 Surveyor's Michigan License No. 25843

Date October 12, 1997

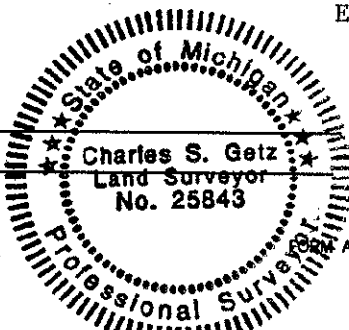

PEER GROUP APPROVED AT  
 MEETING NOVEMBER 5, 1997  
RLB