

SURVEY & REMONUMENTATION

JAN 22 1998

REMONUMENTATION

Re-Man Record 1, Page 74

LAND CORNER RECORDATION CERTIFICATE
Filing Requirement of Act 74, Mich. P.A. 1970

SECTION

For corners in

<u>Huron</u> (County)	Located in:	Corner Code #
1. Public Land Survey Sand Beach	T16N R16E T16N R16E T ___ R ___ T ___ R ___	<u>C-13</u> I _____ _____
2. Property Controlling in Section	S ___ T ___ R ___ S ___ T ___ R ___	_____ _____
3. Miscellaneous Property in Sec.	S ___ T ___ R ___ S ___ T ___ R ___	_____ _____
4. Lot No. _____	Recorded Plat _____	
5. Private Claims _____		

STATE OF MICHIGAN
HURON COUNTY
RECORDED

6 NOV 97 10:26 A.M.

FRANCES L. HOLDWICK
REGISTER OF DEEDS

Register of Deeds Stamp & File Number

	A	B	C	D	E	F	G	H	I	J	K	L	M
1													
2	6		5		4		3		2		1		
3													
4	7		8		9		10		11		12		
5													
6	18		17		16		15		14		13		
7													
8	19		20		21		22		23		24		
9													
10	30		29		28		27		26		25		
11													
12	31		32		33		34		35		36		
13													

I, Charles S. Getz, in a field survey on Aug. 17, 1997 do hereby state that under requirements of P.A. 74, Michigan P.A. of 1970, the corner points mentioned in lines 1 and 2 above were in conformance with regulations and rules therefore as required in the current manual of survey instructions of the United States Department of the Interior, Bureau of Land Management or by a decree of a Court of Law and/or that the corner points mentioned in lines 3, 4 and 5 above were in conformance with the rules of the Michigan Board of Land Surveyors or by a Decree of a Court of Law; established, re-established, monumented, recovered, found as expressed below:

NOTE: Not more than 2 corners, all in the same town and range, may be recorded on this certificate.

A. Description of original monument and accessories and/or subsequent restoration:

C-13 G.L.O., H. Parke D.S. (1834) Co. Surveyor Records - NONE, Co. Rd. Comm. Records - NONE
Set Post Recorded Surveys - NONE, Unrecorded Surveys - NONE
L.C.R.C. - NONE
B. Ash 10", N76°W, 13 Links
Do. 10", N75½°E 3½ Links

G.L.O., H. Parke D.S. Meander Corner (1834) Co. Surveyors Records - NONE
Set Post on the border of Lake Huron Co. Rd. Comm. Records - NONE
Sugar 14", N61½°W, 12 Links Recorded Surveys - NONE, L.C.R.C. - NONE
Hemlock 9", S32°W, 9 Links Unrecorded Surveys - NONE

B. Description of corner evidence found and/or method applied in restoring or reestablishing corner:

C-13
SW Cor, Section 32, T16N-R16E
Found 1/2" Iron Bar
Accepted as the best available evidence of original corner position

GLO Meander Cor, Section 32, T16N-R16E
GLO Meander Cor falls in Lake Huron, original corner position is inaccessible
Set Witness Corner to GLO Meander Corner, 30.0' West of present day High Bank.
Used C-13 and monumentation of "LAUGHLIN McDOWELL PLAT" for line. Said Plat Recorded in Liber 3 of Plats, Page 38

C. Description of monument for corner and accessories established to perpetuate locating the position of the corner:


C-13
SW Cor, Section 32, T16N-R16E
Found 1/2" Iron Bar (Capped)
N05°E 31.31' to Nail in W. Side of 15" Ash
N40°W 36.34' to Nail in W. Side of 24" Ash
S45°W 38.69' to Nail in W. Side of 36" Cottonwood
S10°W 32.15' to Nail in W. Side of 36" Cottonwood
West 2623.70' to S 1/4 Cor, Sec 31, T16N-R16E
East 1856.33' to Witness Cor to GLO Meander Cor, Sec 32, T16N-R16E

Witness Cor to GLO Meander Cor, Section 32, T16N-R16E Set 1/2" Iron Pipe (Capped)
East 97.27' to Recorded Position of GLO Meander Cor
East 30.0' to Top of Present Day High Bank
N80°W 80.67' to Nail in N. Side of 18" Lombardi Poplar
S80°W 81.04' to Nail in N. Side of 12" White Birch
S40°W 69.10' to Nail in E. Side of 12" White Birch
West 1856.33' to SW Cor, Sec 32, T16N-R16E

Signed by Charles S. Getz
Surveyor's Michigan License No. 25843

Date October 12, 1997

PEER GROUP APPROVED AT MEETING NOVEMBER 5, 1997.

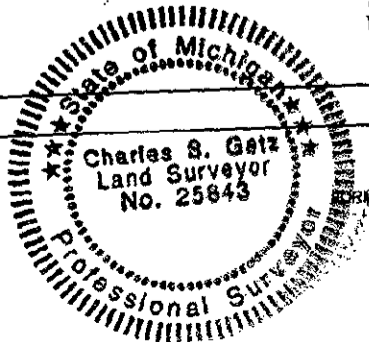

FORM APPROVED BY MICHIGAN STATE BOARD OF PROFESSIONAL SURVEYORS, JAN. 28, 1971
REVISED MAY 14, 1975
REVISED JAN. 1983
REVISED OCT., 1985