

Re-Mon Leher 1, Page 198

1998 REMONUMENTATION

LAND CORNER RECORDATION CERTIFICATE
Filing Requirement of Act 74, Mich. P.A. 1970

STATE OF MICHIGAN
HURON COUNTY
RECORDED

For Corners in

Huron
(County)

Located in:

Corner Code #

SURVEY &
REMONUMENTATION

11 DEC 98 9:45 A.M.

- 1. Public Land survey Fairhaven T 16 N R 9 E
T _____ R _____
T _____ R _____
T _____ R _____
- 2. Property Controlling in Section S _____ T _____ R _____
S _____ T _____ R _____
- 3. Miscellaneous S _____ T _____ R _____

- D-13 ✓
- E-13
- _____
- _____
- _____

JAN 28 1999

FRANCES L. HOLDWICK
REGISTER OF DEEDS

SECTION

Register of Deeds Stamp & File Number

- 4. Lot No. _____, Recorded Plat _____
- 5. Private Claims _____

	A	B	C	D	E	F	G	H	I	J	K	L	M
2	6		5		4		3		2		1		
3													
4	7		8		9		10		11		12		
5													
6	18		17		16		15		14		13		
7													
8	19		20		21		22		23		24		
9													
10	30		29		28		27		26		25		
11													
12	31		32		33		34		35		36		
13													

I, James T. Meek, in a field survey on October 30, 1998, do hereby certify that under requirements of P.A. 74, Michigan P.A. of 1970, the corner points mentioned in lines 1 and 2 above were in conformance with regulations and rules thereof as required in the current manual of survey instructions of the United States Department of the Interior, Bureau of Land Management or by a decree of a Court of Law and/or that the corner points mentioned in lines 3, 4 and 5 above were in conformance with the rules of the Michigan Board of Land Surveyors or by a Decree of a Court of Law; established, re-established, monumented, re-monumented, recovered, found as expressed below:

NOTE: Not more than 4 corners, all in the same town and range, may be recorded on this certificate.

A. Description of original monument and accessories and/or subsequent restoration:
Original Survey South Bdy. T16NR9E, 1835, Harvey Parke, D.S.

D-13 South 1/4 Corner of Section 32
Post
Burr Oak 12", N41°W, 44 links
B. Oak 4", N88°E, 35 links

County surveyors record; none
Recorded surveys: none
LCRC: none

E-13 Corner of Sections 32 and 33
Post
Burr Oak 11", N72 1/2°E, 111 links
Pine 24", N56 1/2°W, 1081 links

County surveyors record; 3/4" iron
Recorded surveys: L5, P55
LCRC: L1, P19

B. Description of corner evidence found and/or method applied in restoring or reestablishing corner:

D-13 South 1/4 Corner of Section 32

There is no remaining evidence of the original corner position.

E-13 Corner of Sections 32 and 33

Found 1/2" iron in mon box
At intersection of Kilmanagh & Rose Island Rds.

Accepted as the best available evidence of the original corner position.

C. Description of monument for corner and accessories established to perpetuate locating the position of the corner:

D-13 South 1/4 Corner of Section 32

Set 1/2" iron w/cap #39089, at record distance.

From which:
Tag in 14" Walnut bears N40°W, 35.8'
1/2" iron 2" below grd. bears N60°E, 96.1'
Spike in PP bears N88°W, 84.3'
Drain leading to Saginaw Bay bears West, 100.0'

E-13 Corner of Sections 32 and 33


1/2" iron in mon box

From which:
Road sign post bears N25°E, 49.3'
Tag in power pole bears S24°E, 67.6'
Road sign post bears S72°W, 51.8'
Telephone box bears N32°W, 71.1'

Signed by [Signature]

Date Dec

Surveyor's Michigan License No. 39089

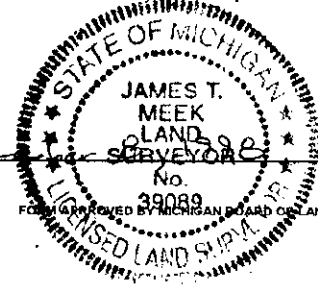

APPROVED AT PEER BOARD MEETING, 11-24-98 RLB