

See Mon Ledger 1, Page 197

LAND CORNER RECORDATION CERTIFICATE
Filing Requirement of Act 74, Mich. P.A. 1970

1998 REMONUMENTATION

For Corners in	Located in:	Corner Code #	SURVEY & REMONUMENTATION	STATE OF MICHIGAN HURON COUNTY RECORDED
<u>Huron</u> (County)				
1. Public Land survey	Fairhaven T <u>16</u> N R <u>9</u> E	F-13 ✓ G-13	JAN 28 1999	11 DEC 98 9:45 A.M.
	T _____ R _____			
	T _____ R _____			
	T _____ R _____			
2. Property Controlling in Section	S _____ T _____ R _____			FRANCES L. HOLDWICK REGISTER OF DEEDS
	S _____ T _____ R _____			
3. Miscellaneous	S _____ T _____ R _____			

Register of Deeds Stamp & File Number

4. Lot No. _____, Recorded Plat _____
 5. Private Claims _____

	A	B	C	D	E	F	G	H	I	J	K	L	M
2	6		5		4		3		2		1		
3													
4	7		8		9		10		11		12		
5													
6	18		17		16		15		14		13		
7													
8	19		20		21		22		23		24		
9													
10	30		29		28		27		26		25		
11													
12	31		32		33		34		35		36		
13													

I, James T. Meek, in a field survey on October 30, 1998, do hereby certify that under requirements of P.A. 74, Michigan P.A. of 1970, the corner points mentioned in lines 1 and 2 above were in conformance with regulations and rules thereof as required in the current manual of survey instructions of the United States Department of the Interior, Bureau of Land Management or by a decree of a Court of Law and/or that the corner points mentioned in lines 3, 4 and 5 above were in conformance with the rules of the Michigan Board of Land Surveyors or by a Decree of a Court of Law; established, re-established, monumented, re-monumented, recovered, found as expressed below:

NOTE: Not more than 4 corners, all in the same town and range, may be recorded on this certificate.

A. Description of original monument and accessories and/or subsequent restoration:
 Original Survey South Bdy. T16NR9E, 1835, Harvey Parke, D.S.

F-13	South ¼ Corner of Section 33 Post Pine 30", N35½°W, 49 links Pine 10", N81°E, 27 links	G-13	Corner of Sections 33 and 34 Post Aspen 10", N82°E, 41 links Pine 10", N53°W, 19 links
	County surveyors record; ½" pipe Recorded surveys: none LCRC: none		County surveyors record; none Recorded surveys: none LCRC: none

B. Description of corner evidence found and/or method applied in restoring or reestablishing corner:


F-13	South ¼ Corner of Section 33 Found 1" iron in mon box 1' South of centerline of Kilmanagh Rd. Accepted as the best available evidence of the original corner position.	G-13	Corner of Sections 33 and 34 Found 1" iron in mon box At intersection of Kilmanagh & Lange Rds. Accepted as the best available evidence of the original corner position.
------	---	------	---

C. Description of monument for corner and accessories established to perpetuate locating the position of the corner:

F-13	South ¼ Corner of Section 33 1" iron in mon box From which: Tag in Power pole bears N67°E, 66.9' Tag in 12" Pine bears South, 37.8' Tag in Power pole bears S60°W, 94.8' Steel gate post bears N2°E, 32.7'	G-13	Corner of Sections 33 and 34 1" iron in mon box From which: Road sign post bears N30°W, 42.5' Tag in PP bears N38°W, 52.5' East leg of direction sign bears S16°W, 16.5' West leg of direction sign bears S81°W, 17.3'
------	--	------	--

Signed by [Signature]
 Surveyor's Michigan License No. 39089

Date December 8

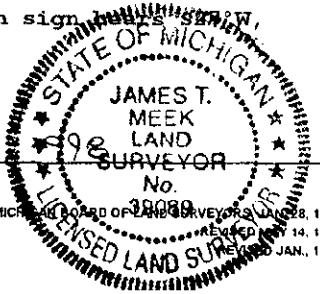

APPROVED AT PEER BOARD MEETING, 11-24-98 RLB