

*Re-Mon Ledw 1, Page 197*

1998 REMONUMENTATION

LAND CORNER RECORDATION CERTIFICATE  
Filing Requirement of Act 74, Mich. P.A. 1970

For Corners in

	<u>Huron</u> (County)	Located in:	Corner Code #
1. Public Land survey	Fairhaven	T 16 N R 9 E	F-13 G-13 ✓
		T _____ R _____	_____
		T _____ R _____	_____
		T _____ R _____	_____
2. Property Controlling in Section	S _____	T _____ R _____	_____
	S _____	T _____ R _____	_____
3. Miscellaneous	S _____	T _____ R _____	_____

SURVEY & REMONUMENTATION  
JAN 28 1999  
SECTION  
Register of Deeds Stamp & File Number

STATE OF MICHIGAN  
HURON COUNTY  
RECORDED  
11 DEC 98 9:45 A.M.  
FRANCES L. HOLDWICK  
REGISTER OF DEEDS

4. Lot No. \_\_\_\_\_, Recorded Plat \_\_\_\_\_  
5. Private Claims \_\_\_\_\_

	A	B	C	D	E	F	G	H	I	J	K	L	M
2	6			5		4		3		2		1	
3													
4	7			8		9		10		11		12	
5													
6	18			17		16		15		14		13	
7													
8	19			20		21		22		23		24	
9													
10	30			29		28		27		26		25	
11													
12	31			32		33		34		35		36	
13													

I, James T. Meek, in a field survey on October 30, 1998, do hereby certify that under requirements of P.A. 74, Michigan P.A. of 1970, the corner points mentioned in lines 1 and 2 above were in conformance with regulations and rules thereof as required in the current manual of survey instructions of the United States Department of the Interior, Bureau of Land Management or by a decree of a Court of Law and/or that the corner points mentioned in lines 3, 4 and 5 above were in conformance with the rules of the Michigan Board of Land Surveyors or by a Decree of a Court of Law; established, re-established, monumented, re-monumented, recovered, found as expressed below:

NOTE: Not more than 4 corners, all in the same town and range, may be recorded on this certificate.

A. Description of original monument and accessories and/or subsequent restoration:  
Original Survey South Bdy. T16NR9E, 1835, Harvey Parke, D.S.

<p>F-13 South ¼ Corner of Section 33 Post Pine 30", N35½°W, 49 links Pine 10", N81°E, 27 links</p> <p>County surveyors record; ½" pipe Recorded surveys: none LCRC: none</p>	<p>G-13 Corner of Sections 33 and 34 Post Aspen 10", N82°E, 41 links Pine 10", N53°W, 19 links</p> <p>County surveyors record; none Recorded surveys: none LCRC: none</p>
--	---

B. Description of corner evidence found and/or method applied in restoring or reestablishing corner:


<p>F-13 South ¼ Corner of Section 33</p> <p>Found 1" iron in mon box 1' South of centerline of Kilmanagh Rd.</p> <p>Accepted as the best available evidence of the original corner position.</p>	<p>G-13 Corner of Sections 33 and 34</p> <p>Found 1" iron in mon box At intersection of Kilmanagh &amp; Lange Rds.</p> <p>Accepted as the best available evidence of the original corner position.</p>
--	--

C. Description of monument for corner and accessories established to perpetuate locating the position of the corner:

<p>F-13 South ¼ Corner of Section 33</p> <p>1" iron in mon box</p> <p>From which: Tag in Power pole bears N67°E, 66.9' Tag in 12" Pine bears South, 37.8' Tag in Power pole bears S60°W, 94.8' Steel gate post bears N2°E, 32.7'</p>	<p>G-13 Corner of Sections 33 and 34</p> <p>1" iron in mon box</p> <p>From which: Road sign post bears N30°W, 42.5' Tag in PP bears N38°W, 52.5' East leg of direction sign bears S16°W, 16.5' West leg of direction sign bears N15°W, 17.3'</p>
--	--

Signed by [Signature]  
Surveyor's Michigan License No. 39089

Date December 8

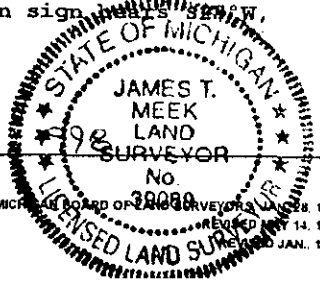

APPROVED AT PEER BOARD MEETING, 11-24-98 RLB