

Re-Mon Liber 1, Page 196

1998 REMONUMENTATION

LAND CORNER RECORDATION CERTIFICATE
Filing Requirement of Act 74, Mich. P.A. 1970

STATE OF MICHIGAN
HURON COUNTY
RECORDED

For Corners in

Huron
(County)

Located in:

Corner Code #

SURVEY &
REMONUMENTATION

11 DEC 98 9:45 A.M.

FRANCES L. HOLDWICK
REGISTER OF DEEDS

1. Public Land survey Fairhaven T 16 N R 9 E
 T _____ R _____
 T _____ R _____
 T _____ R _____
 T _____ R _____
2. Property Controlling S _____ T _____ R _____
 in Section S _____ T _____ R _____
3. Miscellaneous S _____ T _____ R _____

- H-13 ✓
 I-13

JAN 28 1999

SECTION

Register of Deeds Stamp & File Number

4. Lot No. _____, Recorded Plat _____
 5. Private Claims _____

	A	B	C	D	E	F	G	H	I	J	K	L	M
2	6	5	4	3	2	1							
3													
4	7	8	9	10	11	12							
5													
6	18	17	16	15	14	13							
7													
8	19	20	21	22	23	24							
9													
10	30	29	28	27	26	25							
11													
12	31	32	33	34	35	36							
13													

I, James T. Meek, in a field survey on October 30, 1998, do hereby certify that under requirements of P.A. 74, Michigan P.A. of 1970, the corner points mentioned in lines 1 and 2 above were in conformance with regulations and rules thereof as required in the current manual of survey instructions of the United States Department of the Interior, Bureau of Land Management or by a decree of a Court of Law and/or that the corner points mentioned in lines 3, 4 and 5 above were in conformance with the rules of the Michigan Board of Land Surveyors or by a Decree of a Court of Law; established, re-established, monumented, re-monumented, recovered, found as expressed below:

NOTE: Not more than 4 corners, all in the same town and range, may be recorded on this certificate.

A. Description of original monument and accessories and/or subsequent restoration:
 Original survey South Bdy. T16NR9E, 1835, Harvey Parke, D.S.

H-13 South ¼ Corner of Section 34
 Post
 Elm 18", N26°E, 16½ links
 Maple 24", N59°W, 33½ links
 County surveyors record; 1" pin
 Recorded surveys: none
 LCRC: none

I-13 Corner of Sections 34 and 35
 Post
 Sugar 12", N62½°E, 6 links
 Lynn 17", N71°W, 52 links
 County surveyors record; iron pin
 Recorded surveys: none
 LCRC: none

B. Description of corner evidence found and/or method applied in restoring or reestablishing corner:

H-13 South ¼ Corner of Section 34
 Found 1" iron
 Accepted as the best available evidence of the original corner position.

I-13 Corner of Sections 34 and 35
 Found ¾" iron in mon box
 At intersection of Kilmanagh & Kuhl Rds.
 Accepted as the best available evidence of the original corner position.

C. Description of monument for corner and accessories established to perpetuate locating the position of the corner:

H-13 South ¼ Corner of Section 34
 1" iron in mon box
 From which:
 Tag in wood post bears N47°E, 45.6'
 ½" iron bears S45°E, 25.0'
 ½" iron bears S45°W, 20.0'
 ½" iron bears N45°W, 24.0'


I-13 Corner of Sections 34 and 35
 ¾" iron in mon box
 From which:
 Road sign post bears N52°E, 115.5'
 East leg of direction sign bears S18°W, 16.6'
 Road sign post bears S86°W, 102.0'
 Telephone box bears N72°W, 27.1'

Signed by James T. Meek

Date December 8, 1998

Surveyor's Michigan License No. 39089

APPROVED AT PEER BOARD MEETING, 11-24-98 RRB

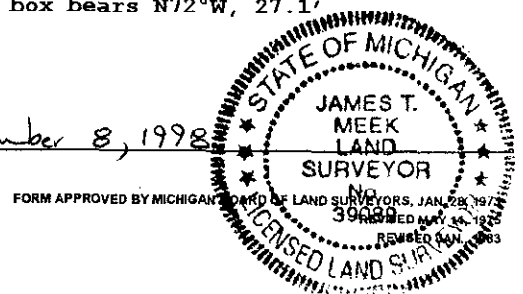

FORM APPROVED BY MICHIGAN BOARD OF LAND SURVEYORS, JAN 28 1977
 39089
 1983