

Re-Mon Liber 1, Page 193

LAND CORNER RECORDATION CERTIFICATE  
Filing Requirement of Act 74, Mich. P.A. 1970

1998 REMONUMENTATION

STATE OF MICHIGAN  
HURON COUNTY  
RECORDED

11 DEC 98 9:44 A.M.

FRANCES L. HOLDWICK  
REGISTER OF DEEDS

For Corners in

Huron  
(County)

Located in:

Corner Code #

SURVEY &  
REMONUMENTATION

JAN 28 1999

SECTION

Register of Deeds Stamp & File Number

- 1. Public Land survey Fairhaven T 16 N R 9 E J-1  
T \_\_\_\_\_ R \_\_\_\_\_  
T \_\_\_\_\_ R \_\_\_\_\_  
T \_\_\_\_\_ R \_\_\_\_\_
- 2. Property Controlling S \_\_\_\_\_ T \_\_\_\_\_ R \_\_\_\_\_  
in Section S \_\_\_\_\_ T \_\_\_\_\_ R \_\_\_\_\_
- 3. Miscellaneous S \_\_\_\_\_ T \_\_\_\_\_ R \_\_\_\_\_  
Property in Sec. S \_\_\_\_\_ T \_\_\_\_\_ R \_\_\_\_\_
- 4. Lot No. \_\_\_\_\_, Recorded Plat \_\_\_\_\_
- 5. Private Claims \_\_\_\_\_

	A	B	C	D	E	F	G	H	I	J	K	L	M
2	6			5			4			3		2	1
3													
4	7			8			9			10		11	12
5													
6	18			17			16			15		14	13
7													
8	19			20			21			22		23	24
9													
10	30			29			28			27		26	25
11													
12	31			32			33			34		35	36
13													

I, James T. Meek, in a field survey on October 30, 1998, do hereby certify that under requirements of P.A. 74, Michigan P.A. of 1970, the corner points mentioned in lines 1 and 2 above were in conformance with regulations and rules thereof as required in the current manual of survey instructions of the United States Department of the Interior, Bureau of Land Management or by a decree of a Court of Law and/or that the corner points mentioned in lines 3, 4 and 5 above were in conformance with the rules of the Michigan Board of Land Surveyors or by a Decree of a Court of Law; established, re-established, monumented, re-monumented, recovered, found as expressed below:

NOTE: Not more than 4 corners, all in the same town and range, may be recorded on this certificate.

A. Description of original monument and accessories and/or subsequent restoration:  
Original survey North Bdy. T16NR9E, 1835, Harvey Parke, D.S.

J-1 Meander Corner of Section 2  
Post  
W. Ash 11", N1°E, 1.67 chains  
Willow 7", S86°E, 3.6 chains  
  
County surveyors record; none  
Recorded surveys: none  
LCRC: none

B. Description of corner evidence found and/or method applied in restoring or reestablishing corner:


J-1 Meander Corner of Section 2  
  
Found 'T' iron w/cap #39089  
  
Accepted as the best available evidence of the original corner position.

C. Description of monument for corner and accessories established to perpetuate locating the position of the corner:

J-1 Meander Corner of Section 2  
  
'T' iron w/cap #39089  
  
From which:  
CL East & West drain bears North, 15.0'  
Tag in 16" Ash bears East 39.0'  
Tag in 12" Ash bears S36°E, 37.0'

Signed by [Signature]  
Surveyor's Michigan License No. 39089

Date December 8, 1998

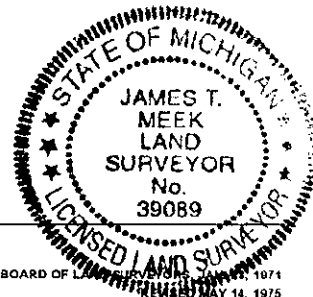

APPROVED AT PEER BOARD MEETING, 11-24-98 RRB