

Common to: A01 - Winsor Twp. - T16N-R10E
 M01 - Fair Haven Twp. - T16N-R9E
 M13 - Fair Haven Twp. - T17N-R9E

Re-Mon. Return, Page 189

1998 REMONUMENTATION

LAND CORNER RECORDATION CERTIFICATE
 Filing Requirement of Act 74, Mich. P.A. 1970

STATE OF MICHIGAN
 HURON COUNTY
 RECORDED

For Corners in

Huron Located in: _____ Corner Code # _____
 (County)

11 DEC 98 9:43 A.M.

- 1. Public Land survey McKinley T 17 N R 10 E
 T _____ R _____
 T _____ R _____
 T _____ R _____
- 2. Property Controlling _____
 in Section S _____ T _____ R _____
 S _____ T _____ R _____
- 3. Miscellaneous _____
 Property in Sec. S _____ T _____ R _____
 S _____ T _____ R _____

SURVEY &
 REMONUMENTATION

FRANCES L. HOLDWICK
 REGISTER OF DEEDS

JAN 28 1999

SECTION

Register of Deeds Stamp & File Number

- 4. Lot No. _____, Recorded Plat _____
- 5. Private Claims _____

| | A | B | C | D | E | F | G | H | I | J | K | L | M |
|----|----|---|----|---|----|---|----|---|----|---|----|---|---|
| 2 | 6 | | 5 | | 4 | | 3 | | 2 | | 1 | | |
| 3 | | | | | | | | | | | | | |
| 4 | 7 | | 8 | | 9 | | 10 | | 11 | | 12 | | |
| 5 | | | | | | | | | | | | | |
| 6 | 18 | | 17 | | 16 | | 15 | | 14 | | 13 | | |
| 7 | | | | | | | | | | | | | |
| 8 | 19 | | 20 | | 21 | | 22 | | 23 | | 24 | | |
| 9 | | | | | | | | | | | | | |
| 10 | 30 | | 29 | | 28 | | 27 | | 26 | | 25 | | |
| 11 | | | | | | | | | | | | | |
| 12 | 31 | | 32 | | 33 | | 34 | | 35 | | 36 | | |
| 13 | | | | | | | | | | | | | |

I, James T. Meek, in a field survey on October 30, 1998, do hereby certify that under requirements of P.A. 74, Michigan P.A. of 1970, the corner points mentioned in lines 1 and 2 above were in conformance with regulations and rules thereof as required in the current manual of survey instructions of the United States Department of the Interior, Bureau of Land Management or by a decree of a Court of Law and/or that the corner points mentioned in lines 3, 4 and 5 above were in conformance with the rules of the Michigan Board of Land Surveyors or by a Decree of a Court of Law; established, re-established, monumented, re-monumented, recovered, found as expressed below:

NOTE: Not more than 4 corners, all in the same town and range, may be recorded on this certificate.

A. Description of original monument and accessories and/or subsequent restoration:
 Original Survey South Bdy. T17NR10E, 1835, Harvey Parke, D.S.

A-13 Corner of Townships 16 and 17 North,
 Ranges 9 and 10 East
 Post
 Lynn 14", S47°E, 23 links
 Elm 12", N37°W, 50½ links
 County surveyors record: axle shaft
 Recorded surveys: none
 LCRC: none

B. Description of corner evidence found and/or method applied in restoring or reestablishing corner:

A-13 Corner of Townships 16 and 17 North,
 Ranges 9 and 10 East

 Found ¾" iron in mon box
 4' East of CL Bay Port Rd.


 Accepted as the best available evidence
 of original corner position

C. Description of monument for corner and accessories established to perpetuate locating the position of the corner:

A-13 Corner of Townships 16 and 17 North,
 Ranges 9 and 10 East

 ¾" iron in mon box

 From which:
 Tag in PP bears S70°E, 76.9'
 Tag in 12" Elm bears S40°W, 58.9'
 ½" iron bears N45°W, 28.0'
 ½" iron bears N45°E, 20.0'

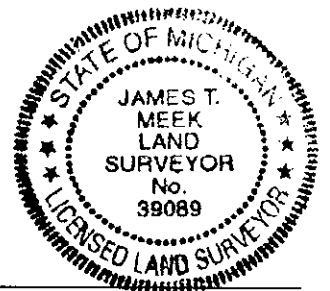

Signed by [Signature] Date December 8, 1998

Surveyor's Michigan License No. 39089

APPROVED AT PEER BOARD MEETING, 11-24-98 R.L.D.