

Re-Monumentation, Page 187

1998 REMONUMENTATION

LAND CORNER RECORDATION CERTIFICATE  
Filing Requirement of Act 74, Mich. P.A. 1970

For Corners in

<u>Huron</u> (County)	Located in:	Corner Code #
1. Public Land survey	McKinley T 17 N R 10 E	D-13 ✓ E-13
2. Property Controlling in Section	S T R	
3. Miscellaneous	S T R	
4. Lot No. _____, Recorded Plat _____		
5. Private Claims _____		

STATE OF MICHIGAN  
HURON COUNTY  
RECORDED

SURVEY & REMONUMENTATION  
DEC 98 9:43 A.M.


JAN 28 1999

FRANCES L. HOLDWICK  
REGISTER OF DEEDS

SECTION

Register of Deeds Stamp & File Number

I, James T. Meek, in a field survey on October 30, 1998, do hereby certify that under requirements of P.A. 74, Michigan P.A. of 1970, the corner points mentioned in lines 1 and 2 above were in conformance with regulations and rules thereof as required in the current manual of survey instructions of the United States Department of the Interior, Bureau of Land Management or by a decree of a Court of Law and/or that the corner points mentioned in lines 3, 4 and 5 above were in conformance with the rules of the Michigan Board of Land Surveyors or by a Decree of a Court of Law; established, re-established, monumented, re-monumented, recovered, found as expressed below:

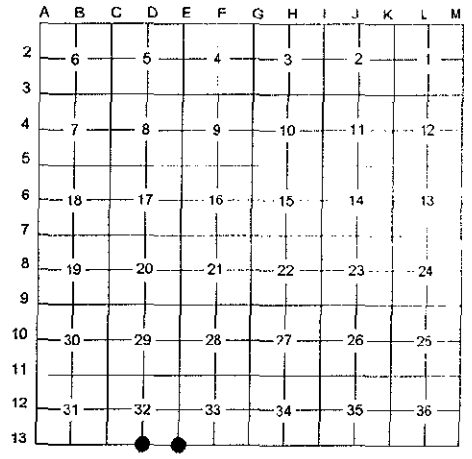

NOTE: Not more than 4 corners, all in the same town and range, may be recorded on this certificate.

A. Description of original monument and accessories and/or subsequent restoration:  
Original Survey South Bdy. T17NR10E, 1835, Harvey Parke, D.S.

D-13 South 1/4 Corner of Section 32  
Post  
Maple 14", N52°W, 45 links  
Beech 12", N59°E, 16 links

E-13 Corner of Sections 32 and 33  
Post  
Hemlock 22", N38°E, 36 links  
Lynn 9", N76°W, 12 1/2 links

County surveyors record; 1/2" pin  
Recorded surveys: none  
LCRC: L1, P44

County surveyors record; none  
Recorded surveys: none  
LCRC: none

B. Description of corner evidence found and/or method applied in restoring or reestablishing corner:

D-13 South 1/4 Corner of Section 32  
Found 1/2" iron

E-13 Corner of Sections 32 and 33  
Found 1/2" iron

Accepted as the best available evidence of the original corner position.

At intersection of Berne & Pobanz Rds.

Accepted as the best available evidence of the original corner position.

C. Description of monument for corner and accessories established to perpetuate locating the position of the corner:

D-13 South 1/4 Corner of Section 32  
1/2" iron

E-13 Corner of Sections 32 and 33  
1/2" iron in mon box

From which:  
1" pipe bears East, 10.0'  
Fence post bears N12°W, 28.3'  
Fence post bears N20°E, 27.8'  
Tag on 8" Walnut bears S50°E, 31.8'  
Tag on 6" Walnut bears S53°W, 17.9'

From which:  
Tag on wood post bears N30°W, 52.65'  
Tag on power pole bears N63°E, 66.6'  
Road sign post bears S45°E, 50.8'  
West leg direction sign post bears S10°W, 53.7'

Signed by James T. Meek

Date December 8, 1998

Surveyor's Michigan License No. 39089

APPROVED AT PEER BOARD MEETING, 11-24-98 RRB

