

Re-Man Lick 1, Page 185

1998 REMONUMENTATION

LAND CORNER RECORDATION CERTIFICATE
Filing Requirement of Act 74, Mich. P.A. 1970

STATE OF MICHIGAN
HURON COUNTY
RECORDED

11 DEC 98 9:43 A.M.

FRANCES L. HOLIWICK
REGISTER OF DEEDS

For Corners in

Huron
(County)

Located in:

Corner Code #

SURVEY &
REMONUMENTATION

JAN 28 1999

SECTION

Register of Deeds Stamp & File Number

- 1. Public Land survey McKinley T 17 N R 10 E
T R
T R
T R
T R
- 2. Property Controlling in Section S T R
S T R
- 3. Miscellaneous S T R

- H-13
- I-13 ✓
-
-
-
-

- 4. Lot No. , Recorded Plat
- 5. Private Claims

	A	B	C	D	E	F	G	H	I	J	K	L	M
2	6		5		4		3		2		1		
3													
4	7		8		9		10		11		12		
5													
6	18		17		16		15		14		13		
7													
8	19		20		21		22		23		24		
9													
10	30		29		28		27		26		25		
11													
12	31		32		33		34		35		36		
13													

I, James T. Meek, in a field survey on October 30, 1998, do hereby certify that under requirements of P.A. 74, Michigan P.A. of 1970, the corner points mentioned in lines 1 and 2 above were in conformance with regulations and rules thereof as required in the current manual of survey instructions of the United States Department of the Interior, Bureau of Land Management or by a decree of a Court of Law and/or that the corner points mentioned in lines 3, 4 and 5 above were in conformance with the rules of the Michigan Board of Land Surveyors or by a Decree of a Court of Law; established, re-established, monumented, re-monumented, recovered, found as expressed below:

NOTE: Not more than 4 corners, all in the same town and range, may be recorded on this certificate.

A. Description of original monument and accessories and/or subsequent restoration:
Original Survey South Bdy. T17NR10E, 1835, Harvey Parke, D.S.

I-13 South 1/4 Corner of Section 34
Post
Hemlock 17", N48°W, 19 links
Sugar 9", N66°E, 25 links

County surveyors record; 5/8" pin
Recorded surveys: none
LCRC: none

I-13 Corner of Sections 34 and 35
Post
Beech 18", N63 1/2°W, 23 links
Beech 12", N63°E, 27 links

County surveyors record; none
Recorded surveys: L3, P61; L4, P763
LCRC: none

B. Description of corner evidence found and/or method applied in restoring or reestablishing corner:

I-13 South 1/4 Corner of Section 34

Found 3/4" iron
At intersection of Berne & Smith Rds.

Accepted as the best available evidence
of the original corner position.

I-13 Corner of Sections 34 and 35

Found 1" iron in mon box
West 2.0' intersection of Berne & Caseville Rds.

Accepted as the best available evidence
of the original corner position.

C. Description of monument for corner and accessories established to perpetuate locating the position of the corner:

I-13 South 1/4 Corner of Section 34

3/4" iron in mon box

From which:
Road sign post bears N25°W, 34.85'
Tag on power pole bears N74°E, 96.0'
West leg of direction sign bears S10°W, 33.85'
Tag on wood post bears N58°W, 60.3'


I-13 Corner of Sections 34 and 35

1" iron in mon box

From which:
Tag on power pole bears N42°W, 65.9'
Tag on power pole bears N48°E, 68.2'
Road sign post bears N78°E, 53.0'
Tag on power pole bears S66°W, 50.5'

Signed by James T. Meek
Surveyor's Michigan License No. 39089

Date December 8, 1998

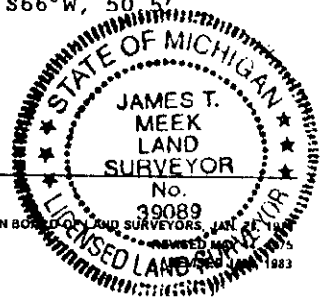

APPROVED AT PEER BOARD MEETING, 11-24-98 R.R.B.