

Re-Mon Liber 1, Page 183

1998 REMONUMENTATION

LAND CORNER RECORDATION CERTIFICATE
Filing Requirement of Act 74, Mich. P.A. 1970

STATE OF MICHIGAN
HURON COUNTY
RECORDED

11 DEC 98 9:42 A.M.

FRANCES L. HOLDWICK
REGISTER OF DEEDS

For Corners in

Huron
(County)

Located in:

Corner Code #

- 1. Public Land survey McKinley T 17 N R 10 E
 T _____ R _____ L-13 ✓
 T _____ R _____ M-13 _____
 T _____ R _____
- 2. Property Controlling _____ S _____ T _____ R _____
 in Section _____ S _____ T _____ R _____
- 3. Miscellaneous _____ S _____ T _____ R _____
- 4. Lot No. _____, Recorded Plat _____
- 5. Private Claims _____

Register of Deeds Stamp & File Number

I, James T. Meek, in a field survey on October 30, 1998, do hereby certify that under requirements of P.A. 74, Michigan P.A. of 1970, the corner points mentioned in lines 1 and 2 above were in conformance with regulations and rules thereof as required in the current manual of survey instructions of the United States Department of the Interior, Bureau of Land Management or by a decree of a Court of Law and/or that the corner points mentioned in lines 3, 4 and 5 above were in conformance with the rules of the Michigan Board of Land Surveyors or by a Decree of a Court of Law; established, re-established, monumented, re-monumented, recovered, found as expressed below:

NOTE: Not more than 4 corners, all in the same town and range, may be recorded on this certificate.

	A	B	C	D	E	F	G	H	I	J	K	L	M
2	6			5		4			3			2	1
3													
4	7			8		9			10			11	12
5													
6	18			17		16			15			14	13
7													
8	19			20		21			22			23	24
9													
10	30			29		28			27			26	25
11													
12	31			32		33			34			35	36
13													

A. Description of original monument and accessories and/or subsequent restoration:
Original Survey South Bdy. T17NR10E, 1835, Harvey Parke, D.S.

L-13 South ¼ Corner of Section 36
Post
Lynn 8", N39°E, 35 links
Elm 9", N33°W, 23 links

County surveyors record; none
Recorded surveys: none
LCRC: none

M-13 Corner of Townships 16 and 17 North, Ranges 10 & 11 East
Post
B. Ash 22", S62°E, 36 links
Birch 10", S75°W, 4 links

County surveyors record; none
Recorded surveys: none
LCRC: none

B. Description of corner evidence found and/or method applied in restoring or reestablishing corner:

L-13 South ¼ Corner of Section 36

There is no remaining evidence of the original corner position.

M-13 Corner of Townships 16 and 17 North, Ranges 10 & 11 East

Found 1" iron in mon box

At intersection of Berne & Gagetown Rds.

Accepted as the best available evidence of the original corner position.

SURVEY &
REMONUMENTATION

JAN 28 1999

SECTION

C. Description of monument for corner and accessories established to perpetuate locating the position of the corner:

L-13 South ¼ Corner of Section 36

Set ½" iron w/cap #39089 in mon box at proportionate distance

From which:
Tag on power pole N2°E, 49.8'
Fence post bears S15°E, 41.8'
½" iron bears S45°W, 24.0'
½" iron bears N45°W, 22.0'


M-13 Corner of Townships 16 and 17 North, Ranges 10 & 11 East

1" iron in mon box

From which:
Concrete row marker bears N54°E, 45.6'
Road sign post bears S26°E, 34.0'
Concrete row marker bears S47°W, 54.1'
Tag on power pole bears N65°W, 75.75'

Signed by [Signature]
Surveyor's Michigan License No. 39089

Date December 8, 1998

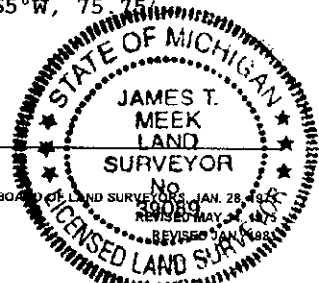

FORM APPROVED BY MICHIGAN BOARD OF LAND SURVEYORS, JAN. 28, 1998

APPROVED AT PEER BOARD MEETING, 11-24-98 RLB