

Re-Mon. Section 1, Page 180

1998 REMONUMENTATION

LAND CORNER RECORDATION CERTIFICATE  
Filing Requirement of Act 74, Mich. P.A. 1970

For Corners in

<u>Huron</u> (County)	Located in:	Corner Code #
1. Public Land survey	Chandler T <u>17</u> N R <u>11</u> E	C-13 ✓ D-13
	T _____ R _____	_____
	T _____ R _____	_____
2. Property Controlling in Section	S _____ T _____ R _____	_____
	S _____ T _____ R _____	_____
3. Miscellaneous	S _____ T _____ R _____	_____
4. Lot No. _____, Recorded Plat _____		
5. Private Claims _____		

STATE OF MICHIGAN  
HURON COUNTY  
RECORDED

11 DEC 98 9:42 A.M.

FRANCES L. HOLDWICK  
REGISTER OF DEEDS

Register of Deeds Stamp & File Number

I, James T. Meek, in a field survey on October 30, 1998, do hereby certify that under requirements of P.A. 74, Michigan P.A. of 1970, the corner points mentioned in lines 1 and 2 above were in conformance with regulations and rules thereof as required in the current manual of survey instructions of the United States Department of the Interior, Bureau of Land Management or by a decree of a Court of Law and/or that the corner points mentioned in lines 3, 4 and 5 above were in conformance with the rules of the Michigan Board of Land Surveyors or by a Decree of a Court of Law; established, re-established, monumented, re-monumented, recovered, found as expressed below:

NOTE: Not more than 4 corners, all in the same town and range, may be recorded on this certificate.

A. Description of original monument and accessories and/or subsequent restoration:  
Original Survey South Bdy. T17NR11E, 1835, Harvey Parke, D.S.

C-13 Corner of Sections 31 & 32  
Post  
Cedar 7", N55½°E, 4½ links  
B. Ash 17", N73°W, 44 links  
  
County surveyors record; pin  
Recorded surveys; none  
No LCRC

D-13 South ¼ Corner of Section 32  
Post  
W. Ash 14", N89°E, 35 links  
Lynn 12", N46°W, 42 links  
  
County Surveyors Record: iron rod  
Recorded surveys; none  
No LCRC

B. Description of corner evidence found and/or method applied in restoring or reestablishing corner:

C-13 Corner of Sections 31 & 32  
  
Found 1" iron in mon box  
  
10' East of intersection of Berne & Maxwell Rds.  
Drain runs North & South  
  
Accepted as the best available evidence of the original corner position.

D-13 South ¼ Corner of Section 32  
  
There is no remaining evidence of the original corner position.

C. Description of monument for corner and accessories established to perpetuate locating the position of the corner:

C-13 Corner of Sections 31 & 32  
  
1" iron in mon box  
  
From which:  
Tag in power pole bears N20°E, 54.3'  
Road sign post bears S9°W, 36.5'  
Road sign post bears N54°W, 46.6'  
¾" iron in mon box bears West 19.6'

D-13 South ¼ Corner of Section 32  
  
At proportionate distance  
  
Set ¾" iron w/cap #39089 in mon box  
  
From which:  
At centerline of Berne Road  
Tag in power pole bears N10°W, 99.75'  
Fence post bears S15°W, 87.2'  
Telephone box bears S45°W, 70.7'  
¾" iron in mon box bears West \_\_\_\_\_

	A	B	C	D	E	F	G	H	I	J	K	L	M
2	6		5		4		3		2		1		
3													
4	7		8		9		10		11		12		
5													
6	18		17		16		15		14		13		
7													
8	19		20		21		22		23		24		
9													
10	30		29		28		27		26		25		
11													
12	31		32		33		34		35		36		
13													


Signed by James T. Meek  
Surveyor's Michigan License No. 39089  
APPROVED AT PEER BOARD MEETING, 11-24-98 RRB

Date December 8, 1998

SURVEY &  
REMONUMENTATION

JAN 28 1999

SECTION

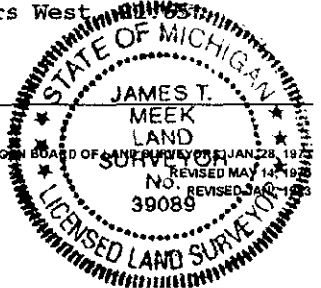

FORM APPROVED BY MICHIGAN BOARD OF LAND SURVEYORS