

1998 REMONUMENTATION

LAND CORNER RECORDATION CERTIFICATE
Filing Requirement of Act 74, Mich. P.A. 1970

For Corners in

	<u>Huron</u> (County)	Located in:	Corner Code #
1. Public Land survey	Chandler	T 17 N R 11 E	E-13 ✓ F-13
		T _____ R _____	_____
		T _____ R _____	_____
		T _____ R _____	_____
2. Property Controlling in Section	S _____	T _____ R _____	_____
	S _____	T _____ R _____	_____
3. Miscellaneous	S _____	T _____ R _____	_____

STATE OF MICHIGAN
HURON COUNTY
RECORDED

11 DEC 98 9:41 A.M.

FRANCES L. HOLDWICK
REGISTER OF DEEDS
Register of Deeds Stamp & File Number

- 4. Lot No. _____, Recorded Plat _____
- 5. Private Claims _____

	A	B	C	D	E	F	G	H	I	J	K	L	M
2	6		5		4		3		2		1		
3													
4	7		8		9		10		11		12		
5													
6	18		17		16		15		14		13		
7													
8	19		20		21		22		23		24		
9													
10	30		29		28		27		26		25		
11													
12	31		32		33		34		35		36		
13													

I, James T. Meek, in a field survey on October 30, 1998, do hereby certify that under requirements of P.A. 74, Michigan P.A. of 1970, the corner points mentioned in lines 1 and 2 above were in conformance with regulations and rules thereof as required in the current manual of survey instructions of the United States Department of the Interior, Bureau of Land Management or by a decree of a Court of Law and/or that the corner points mentioned in lines 3, 4 and 5 above were in conformance with the rules of the Michigan Board of Land Surveyors or by a Decree of a Court of Law; established, re-established, monumented, re-monumented, recovered, found as expressed below.

NOTE: Not more than 4 corners, all in the same town and range, may be recorded on this certificate.

A. Description of original monument and accessories and/or subsequent restoration:
Original Survey South Bdy. T17NR11E, 1835, Harvey Parke, D.S.

- | | | | |
|------|--|------|--|
| E-13 | Corner of Sections 32 & 33
Post
Cedar 12", N88°W, 27 links
Lynn 16", N10°E, 17 links

County surveyors record; steel pin
Recorded surveys; L1, P436
No LCRC | F-13 | South ¼ Corner of Section 33
Post
Hemlock 9", N54½°E, 34 links
Hemlock 12", N16½°W, 4 links

County Surveyors Record: none
Recorded surveys; none
No LCRC |
|------|--|------|--|

B. Description of corner evidence found and/or method applied in restoring or reestablishing corner:

- | | | | |
|------|---|------|--|
| E-13 | Corner of Sections 32 & 33

Found ½" iron in mon box

At intersection Berne & Farver Rds.

Accepted as the best available evidence of the original corner position. | F-13 | South ¼ Corner of Section 33

Found 1" iron in mon box

Accepted as the best available evidence of the original corner position. |
|------|---|------|--|

SURVEY & REMONUMENTATION

JAN 28 1999

C. Description of monument for corner and accessories established to perpetuate locating the position of the corner: SECTION

- | | | | |
|------|--|------|---|
| E-13 | Corner of Sections 32 & 33

½" iron in mon box


From which:
Road sign post bears N15 °W, 52.85'
Tag in power pole bears N30°E, 74.4'
Road sign post bears S20°E, 34.7'
1" iron in mon box bears West, 4.0' | F-13 | South ¼ Corner of Section 33

1" iron in mon box

From which:
Tag in power pole bears North 52.7'
½" iron bears N45°W, 27.0'
Fence post bears S40°E, 20.0'
½" iron bears S45°W, 25.0' |
|------|--|------|---|

Signed by [Signature]
Surveyor's Michigan License No. 39089

Date December 8, 1998

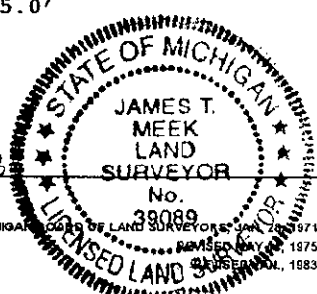

APPROVED AT PEER BOARD MEETING, 11-24-98 R&B