

Re-Mon. Liber 1, Page 201

1998 REMONUMENTATION
LAND CORNER RECORDATION CERTIFICATE
Filing Requirement of Act 74, Mich. P.A. 1970

For Corners in CHANDLER Township

Huron
(County)

Located in:

Corner Code #

SURVEY &
REMONUMENTATION

JAN 28 1999

SECTION

STATE OF MICHIGAN
HURON COUNTY
RECORDED

15 DEC 98 3:29 P.M.


FRANCES L. HOLDWICK
REGISTER OF DEEDS

Register of Deeds Stamp & File Number

1. Public Land Survey	T	17N	R	11E	G-13
	T	-----	R	-----	-----
	T	-----	R	-----	-----
	T	-----	R	-----	-----
2. Property Controlling in Section	S	-----	T	-----	R
	S	-----	T	-----	R
3. Miscellaneous Property in Sec.	S	-----	T	-----	R
	S	-----	T	-----	R

4. Lot No. _____, Recorded Plat _____
5. Private Claims _____

I, Russell L. Brown, in a field survey on August 31, 1998 do hereby state that under requirements of P.A. 74, Michigan P.A. of 1970, the corner points mentioned in lines 1 and 2 above were in conformance with regulations and rules therefore as required in the current manual of survey instructions of the United States Department of the Interior, Bureau of Land Management or by a decree of a Court of Law and/or that the corner points mentioned in lines 3, 4, and 5 above were in conformance with the rules of the Michigan Board of Land Surveyors or by a Decree of a Court of Law; established, re-established, monumented, recovered, found as expressed below:

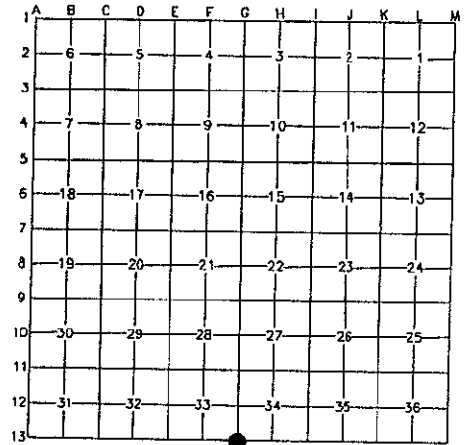

NOTE: Not more than 2 corners, all in the same town and range, may be recorded on this certificate.

A. Description of original monument and accessories and/or subsequent restoration:

1834 G.L.O. H. Parke D.S.; Set Post Corner Sections 33 and 34, ; Pine 30 N45W 16.; Birch 12 N75E 13;
County Surveyors Records: NONE
County Road Commission Records: NONE
Recorded Surveys: NONE
Unrecorded Surveys: NONE

B. Description of corner evidence found and/or method applied in restoring or reestablishing corner:

No evidence of original corner or accessories found.

Found 3/4" Re-Rod in Monument Box.

Accepted Found 3/4" Re-Rod in Monument Box as best evidence of original corner position.

C. Description of monument for corner and accessories established to perpetuate locating the position of the corner:

G-13, S.E. Corner Section 33 and the S.W. Corner Section 34, T17N-R11E,
Found 3/4" Re-Rod in Monument Box.

WITNESSES:

- N45°W 71.89' found Spike in Southwest Face of power Pole
- S45°W 64.20' set Spike Southeast Face Ped Support Post
- S45°E 70.44' found Spike in Northeast Face Power Pole
- S80°E 174.26' found Spike in North Face Power Pole

East 2638.83' to H-13, South 1/4 Corner Section 34, T17N-R11E
West 2631.04' to F-13, South 1/4 Corner Section 33, T17N-R11E

Signed by Russell L. Brown
Surveyor's Michigan License No. 24588

Date DEC. 7, 1998



Peer group approved at meeting held December 8, 1998.

R.L.B.