

Re-Mon Liber 1, Page 202

1998 REMONUMENTATION
LAND CORNER RECORDATION CERTIFICATE
Filing Requirement of Act 74, Mich. P.A. 1970

For Corners in CHANDLER Township

Huron
(County)

Located in: Corner Code #

SURVEY &
REMONUMENTATION

STATE OF MICHIGAN
HURON COUNTY
RECORDED

- 1. Public Land Survey T 17N R 11E H-13
T ----- R -----
T ----- R -----
T ----- R -----
- 2. Property Controlling S _____ T ----- R -----
in Section S _____ T ----- R -----
- 3. Miscellaneous S _____ T ----- R -----
Property in Sec. S _____ T ----- R -----

JAN 28 1999

15 DEC 98 3:29 P.M.


FRANCES L. HOLDWICK
REGISTER OF DEEDS

SECTION

Register of Deeds Stamp & File Number

- 4. Lot No. _____, Recorded Plat _____
- 5. Private Claims _____

I, Russell L. Brown, in a field survey on August 14, 1998 do hereby state that under requirements of P.A. 74, Michigan P.A. of 1970, the corner points mentioned in lines 1 and 2 above were in conformance with regulations and rules therefore as required in the current manual of survey instructions of the United States Department of the Interior, Bureau of Land Management or by a decree of a Court of Law and/or that the corner points mentioned in lines 3, 4, and 5 above were in conformance with the rules of the Michigan Board of Land Surveyors or by a Decree of a Court of Law; established, re-established, monumented, recovered, found as expressed below:

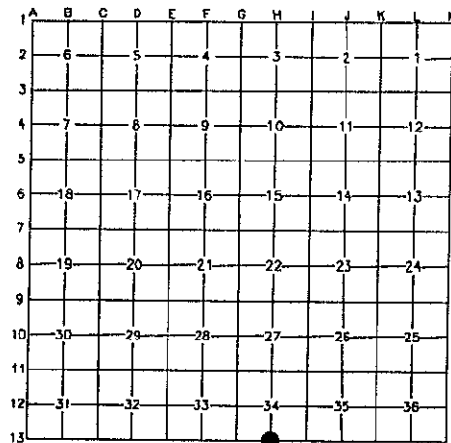

NOTE: Not more than 2 corners, all in the same town and range, may be recorded on this certificate.

A. Description of original monument and accessories and/or subsequent restoration:

1834 G.L.O. H. Parke D.S.; Set quarter Section Post.; Aspen 13 N59W 18.; Cedar 8 N33E 10.;
County Surveyors Records: NONE
County Road Commission Records: NONE
Recorded Surveys: Sept. 28, 1973, Liber 1, Page 583 by Stewart G. Case P.S. 15399; Found 3/4" Iron Pin in place, raised with 1 1/4" Pipe; WITNESSES: 1/2" Iron Pin; South 33.65'; 1/2" Iron Pin, North 33.75'; Spike in S.W. Side T.P., N50°W 44.75'
Unrecorded Surveys: NONE

B. Description of corner evidence found and/or method applied in restoring or reestablishing corner:

No evidence of original corner of accessories found.

Found 3/4" Re-Rod in Monument Box

Accepted Found 3/4" Re-Rod in Monument Box as best evidence of original corner position.

C. Description of monument for corner and accessories established to perpetuate locating the position of the corner:

H-13, South 1/4 Corner Section 34, T17N-R11E

Found 3/4" Re-Rod in Monument Box

WITNESSES:


North 82.83' found Spike in West Face Elm

South 33.55' set 1/2" Steel Stake

S60°W 144.23' to N.W. Corner House

N75°W 48.03' set 1/2" Short Iron

East 2635.52' to I-13, Corner Common to Sections 34 and 35, T17N-R11E,
West 2638.83' to G-13, Corner Common to Sections 33 and 34, T17N-R11E,

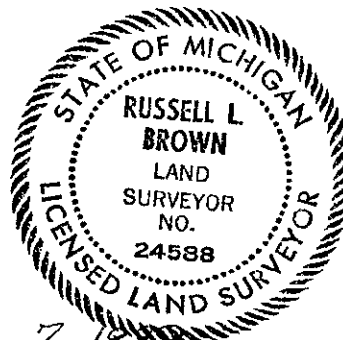

Signed by Russell L. Brown
Surveyor's Michigan License No. 24588

Date Dec 7, 1998

Peer group approved at meeting held December 8, 1998. RLB