

Re-Mon. Liber 1, Page 203

1998 REMONUMENTATION
LAND CORNER RECORDATION CERTIFICATE
Filing Requirement of Act 74, Mich. P.A. 1970

For Corners in CHANDLER Township

Huron
(County)

Located in:

Corner Code #

SURVEY &
REMONUMENTATION

STATE OF MICHIGAN
HURON COUNTY
RECORDED

- 1. Public Land Survey T 17N R 11E I-13
 T ----- R -----
 T ----- R -----
 T ----- R -----
- 2. Property Controlling S _____ T ----- R -----
 in Section S _____ T ----- R -----
- 3. Miscellaneous S _____ T ----- R -----
 Property in Sec. S _____ T ----- R -----

JAN 28 1999

SECTION


15 DEC 98 3:29 P.M.

FRANCES L. HOLDWICK
REGISTER OF DEEDS

Register of Deeds Stamp & File Number

- 4. Lot No. _____, Recorded Plat _____
- 5. Private Claims _____

I, Russell L. Brown, in a field survey on August 14, 1998 do hereby state that under requirements of P.A. 74, Michigan P.A. of 1970, the corner points mentioned in lines 1 and 2 above were in conformance with regulations and rules therefore as required in the current manual of survey instructions of the United States Department of the Interior, Bureau of Land Management or by a decree of a Court of Law and/or that the corner points mentioned in lines 3, 4, and 5 above were in conformance with the rules of the Michigan Board of Land Surveyors or by a Decree of a Court of Law; established, re-established, monumented, recovered, found as expressed below:

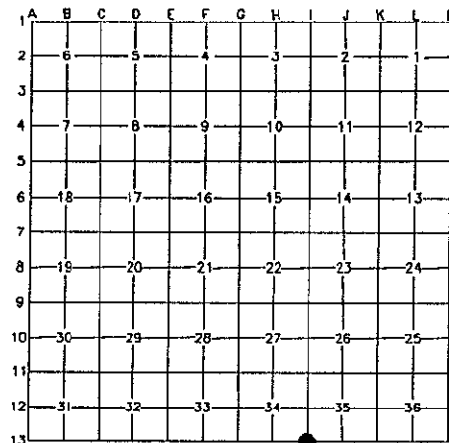

NOTE: Not more than 2 corners, all in the same town and range, may be recorded on this certificate.

A. Description of original monument and accessories and/or subsequent restoration:

1834 G.L.O. H. Parker D.S.; Set Post Corner Sections 34 and 35.; Hemlock 28 N81 1/2E 34, Hemlock 9 N44W 11.

County Surveyors Records: NONE

County Road Commission Records: NONE

Recorded Surveys: June 1971, Liber 1, Page 33, by Stewart G. Case P.S. 15399.; Found 3/4" Iron Pin in Cedar Post

in place and in line with fence to North. WITNESSES: Face of P.P., S55°E 74.90'; Face of T.P., S25°E 69.10'; Guy

Pole, S65°W 70.0'; Fence Post, North 31.0'; Sept. 28, 1973, Liber 1, Page 583 by Stewart G. Case P.S. 15399;

Found 3/4" Iron Pin in place, raised with 1" Pipe; WITNESSES: Spike in W. Side cedar Post; North 30.50; Spike in

N.E. Side T.P., S22°E 69.60"; Spike in N.W. Side T.P. S65°W 70.35'.

Unrecorded Surveys: NONE

B. Description of corner evidence found and/or method applied in restoring or reestablishing corner:

No evidence of original corner or accessories found.

Found 1/2" Steel Stake

Accepted Found 1/2" Steel Stake as best evidence of original corner position.

C. Description of monument for corner and accessories established to perpetuate locating the position of the corner:

I-13, Southeast Corner Section 34 and Southwest Corner Section 35, T17N-R11E,

Found 1/2" Steel Stake

WITNESSES:

S55°E 71.13' found Spike in Southwest Face of Power Pole


S25°E 69.10' found Spike in Northwest Face of Telephone Pole

S65°W 70.0' found Guy Pole

N55°E 39.16' set Spike in Southeast face White Oak

East 2626.11' to J-13, South 1/4 Corner Section 35, T17N-R11E

West 2635.52' to H-13, South 1/4 Corner Section 34, T17N-R11E

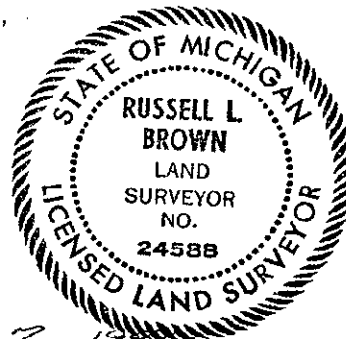

Signed by Russell L. Brown
Surveyor's Michigan License No. 24588

Date DEC. 7, 1998

Peer group approved at meeting held December 8, 1998. RXB