

Re-Mon Leber, Page 204

1998 REMONUMENTATION  
LAND CORNER RECORDATION CERTIFICATE  
Filing Requirement of Act 74, Mich. P.A. 1970

For Corners in CHANDLER Township

<u>Huron</u> (County)	Located in:	Corner Code #
1. Public Land Survey	T <u>17N</u> R <u>11E</u>	J-13
	T-----R-----	_____
	T-----R-----	_____
	T-----R-----	_____
2. Property Controlling in Section	S-----T-----	_____
	S-----T-----	_____
3. Miscellaneous Property in Sec.	S-----T-----	_____
	S-----T-----	_____

SURVEY &  
REMONUMENTATION

JAN 28 1999

SECTION

STATE OF MICHIGAN  
HURON COUNTY  
RECORDED

15 DEC 98 3:29 P.M.


FRANCES L. HOLMICK  
REGISTER OF DEEDS

Register of Deeds Stamp & File Number

4. Lot No. \_\_\_\_\_, Recorded Plat \_\_\_\_\_  
5. Private Claims \_\_\_\_\_

I, Russell L. Brown, in a field survey on August 7, 1998 do hereby state that under requirements of P.A. 74, Michigan P.A. of 1970, the corner points mentioned in lines 1 and 2 above were in conformance with regulations and rules therefore as required in the current manual of survey instructions of the United States Department of the Interior, Bureau of Land Management or by a decree of a Court of Law and/or that the corner points mentioned in lines 3, 4, and 5 above were in conformance with the rules of the Michigan Board of Land Surveyors or by a Decree of a Court of Law; established, re-established, monumented, recovered, found as expressed below:

NOTE: Not more than 2 corners, all in the same town and range, may be recorded on this certificate.

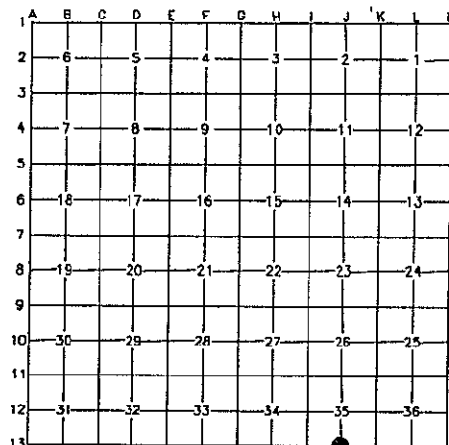

A. Description of original monument and accessories and/or subsequent restoration:

1834 G.L.O. H. Parke D.S. Set quarter Section post; Hemlock 7 N84W 6 1/2,: Beech 7 N67 1/2E 4.

County Surveyors Records: NONE

County Road Commission Records: NONE

Recorded Surveys: NONE

Unrecorded Surveys: NONE

B. Description of corner evidence found and/or method applied in restoring or reestablishing corner:

No evidence of original corner or accessories found.

Found 3/4" Re-Rod.

Accepted Found 3/4" Re-Rod as best evidence of original corner position.

C. Description of monument for corner and accessories established to perpetuate locating the position of the corner:

J-13, South 1/4 Corner Section 35, T17N-R11E

Found 3/4" Re-Rod

WITNESSES:

N45°W 24.72' set 1/2" x 18" Re-Rod


N45°E 27.72' set 1/2" x 18" Re-Rod

S50°E 30.18' set 1/2" x 18" Re-Rod

S45°W 23.63' set 1/2" x 18" Re-Rod

East 2631.41' to K-13, Corner Sections 35 and 36, T17N-R11E,

West 2626.11' to I-13, Corner Sections 34 and 35, T17N-R11E

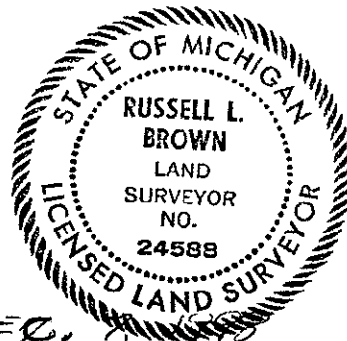

Signed by Russell L. Brown  
Surveyor's Michigan License No. 24588

Date DEC. 1998

Peer group approved at meeting held December 8, 1998. RLB