

Re-Mon Liber 1, Page 206

1998 REMONUMENTATION
LAND CORNER RECORDATION CERTIFICATE
Filing Requirement of Act 74, Mich. P.A. 1970

For Corners in CHANDLER Township

Huron
(County)

Located in: Corner Code #

- 1. Public Land Survey T 17N R 11E L-13
T ----- R -----
T ----- R -----
T ----- R -----
- 2. Property Controlling S ----- T ----- R -----
in Section S ----- T ----- R -----
- 3. Miscellaneous S ----- T ----- R -----
Property in Sec. S ----- T ----- R -----

SURVEY &
REMONUMENTATION

JAN 28 1999

SECTION

STATE OF MICHIGAN
HURON COUNTY
RECORDED

15 DEC 98 3:29 P.M.

FRANCES L. HOLDWICK
REGISTER OF DEEDS

Register of Deeds Stamp & File Number

- 4. Lot No. _____, Recorded Plat _____
- 5. Private Claims _____

1	A	B	C	D	E	F	G	H	I	J	K	L	M
2	6		5		4		3		2		1		
3													
4	7		8		9		10		11		12		
5													
6	18		17		16		15		14		13		
7													
8	19		20		21		22		23		24		
9													
10	30		29		28		27		26		25		
11													
12	31		32		33		34		35		36		
13													

I, Russell L. Brown, in a field survey on July 31, 1998 do hereby state that under requirements of P.A. 74, Michigan P.A. of 1970, the corner points mentioned in lines 1 and 2 above were in conformance with regulations and rules therefore as required in the current manual of survey instructions of the United States Department of the Interior, Bureau of Land Management or by a decree of a Court of Law and/or that the corner points mentioned in lines 3, 4, and 5 above were in conformance with the rules of the Michigan Board of Land Surveyors or by a Decree of a Court of Law; established, re-established, monumented, recovered, found as expressed below:

NOTE: Not more than 2 corners, all in the same town and range, may be recorded on this certificate.

A. Description of original monument and accessories and/or subsequent restoration:

1834 G.L.O. H. Parke D.S.; Set quarter Section Post; Elm 30, N62W 16.; Fir 9, N73 1/2E, 18.
County Surveyors Records: NONE
County Road Commission Records; NONE
Recorded Surveys: NONE
Unrecorded Surveys: NONE

B. Description of corner evidence found and/or method applied in restoring or reestablishing corner:


No evidence of original corner or accessories found.

Set 1/2" x 18" Re-Rod, capped 24588 by single proportionate measurement between K-13 and M-13.

Accepted single proportionate measurement as best evidence of original corner position.

C. Description of monument for corner and accessories established to perpetuate locating the position of the corner:

L-13, S. 1/4 Corner Section 36, T17N-R11E
Set 1/2" x 18" Re-Rod capped 24588
WITNESSES:
S45°E 23.78' set 1/2" x 18" Steel Stake
N55°E 26.06' set 1/2" x 18" Steel Stake
N45°W 23.10' set 1/2" x 18" Steel Stake
S25°W 28.05' set P.K. Nail in West side Corner Post
East 2621.60' to Corner T17N-R11E, and T16N-R11E, T17N-R12E, and T16N-R12E.
West 2621.60' to K-13, Corner Sections 35 and 36, T17N-R11E

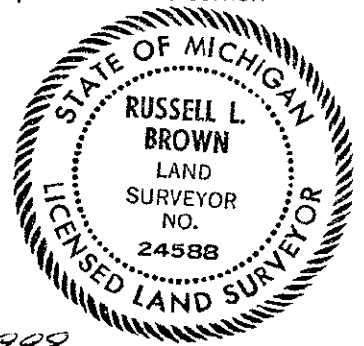

Signed by Russell L. Brown
Surveyor's Michigan License No. 24588

Date DEC. 7, 1998

Peer group approved at meeting held December 8, 1998. RLLB