

Common to: A13 - Meade Twp. - T17N-R12E
 A01 - Colfax Twp. - T16N-R12E
 M01 - Oliver Twp. - T16N-R11E

Re-Mon Liller 1, Page 207

**1998 REMONUMENTATION
 LAND CORNER RECORDATION CERTIFICATE
 Filing Requirement of Act 74, Mich. P.A. 1970**

For Corners in CHANDLER Township

<u>Huron</u> (County)	Located in:	Corner Code #
1. Public Land Survey	T <u>17N</u> R <u>11E</u>	M-13
	T ----- R -----	_____
	T ----- R -----	_____
	T ----- R -----	_____
2. Property Controlling in Section	S _____ T ----- R -----	_____
	S _____ T ----- R -----	_____
3. Miscellaneous Property in Sec.	S _____ T ----- R -----	_____
	S _____ T ----- R -----	_____

**SURVEY &
 REMONUMENTATION**

STATE OF MICHIGAN
 HURON COUNTY
 RECORDED

15 DEC 98 3:30 P.M.


JAN 28 1999

FRANCES L. HOLDWICK
 REGISTER OF DEEDS

SECTION

Register of Deeds Stamp & File Number

4. Lot No. _____, Recorded Plat _____
 5. Private Claims _____

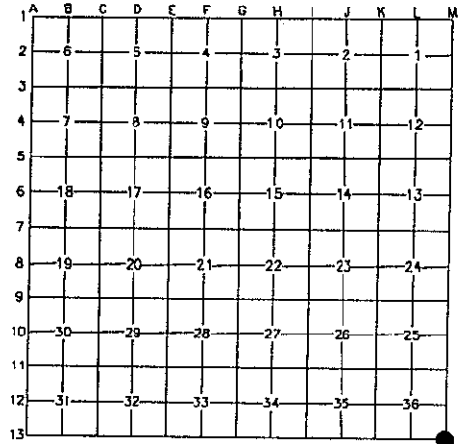

I, Russell L. Brown, in a field survey on July 31, 1998 do hereby state that under requirements of P.A. 74, Michigan P.A. of 1970, the corner points mentioned in lines 1 and 2 above were in conformance with regulations and rules therefore as required in the current manual of survey instructions of the United States Department of the Interior, Bureau of Land Management or by a decree of a Court of Law and/or that the corner points mentioned in lines 3, 4, and 5 above were in conformance with the rules of the Michigan Board of Land Surveyors or by a Decree of a Court of Law; established, re-established, monumented, recovered, found as expressed below:

NOTE: Not more than 2 corners, all in the same town and range, may be recorded on this certificate.

A. Description of original monument and accessories and/or subsequent restoration:

1834 G.L.O. H. Parke D.S., Set as SW Corner Section 31, T17N-R12E, Hemlock 10, N71W, 7; Hemlock 12, S88E, 15
 County Surveyors Records: NONE
 County Road Commission Records: Iron Pin: Spike 8" Maple, NW 69.60', Spike 6" Maple, NW 46.0', Spike 8" Maple, NW 71.90'; Spike 12" Maple, SE 44.0'
 Recorded Surveys: NONE
 Unrecorded Surveys: NONE

B. Description of corner evidence found and/or method applied in restoring or reestablishing corner:
 No evidence of original corner or accessories found.

Found R.R.S. Removed R.R.S. Set 3/4" x 24" Re-Rod, Reset R.R.S. over 3/4" Re-Rod.

Accepted R.R.S. as best evidence of original corner position.

C. Description of monument for corner and accessories established to perpetuate locating the position of the corner:

M-13 S.E. Corner Section 36, T17N-R11E
 R.R.S. over 3/4" x 24" Re-Rod
 WITNESSES:
 S45°E 44.18' found Spike in Northwest Face 36" Red Maple
 S70°E 97.76' found Spike in North Face 30" Stump
 N45°E 35.25' set 1/2" Steel Stake
 S30°W 41.32' set Chisled "x" in West End 18" C.M.P.
 East 2620.20' to B-13, South 1/4 Corner Section 31, T17N-R12E
 West 2621.60' to L-13, South 1/4 Corner Section 36, T17N-R11E

NOTE:
 This corner is common with
 A-13, T17N-R12E,
 M-1, T16N-R11E,
 A-1, T16N-R12E



Signed by Russell L. Brown
 Surveyor's Michigan License No. 24588

Date Dec. 7, 1998

Peer group approved at meeting held December 8, 1998. *R&B*