

Common to:
 M01 - Chandler Twp. - T17N-R11E
 M13 - Lake Twp. - T18N-R11E
 A13 - Hume Twp. - T18N-R12E

Re-Mon. Liber 2, Page 12

1999 REMONUMENTATION

LAND CORNER RECORDATION CERTIFICATE
 Filing Requirement of Act 74, Mich. P.A. 1970

RECORDED

For Corners in

<u>Huron</u> (County)	Located in:	Corner Code #
1. Public Land survey: Meade	T 17_N_ R 12_E	<u>A-1</u>
	T _____ R _____	_____
	T _____ R _____	_____
	T _____ R _____	_____
2. Property Controlling	S _____ T _____ R _____	_____
in Section	S _____ T _____ R _____	_____
3. Miscellaneous	S _____ T _____ R _____	_____
Property in Sec.	S _____ T _____ R _____	_____
4. Lot No. _____, Recorded Plat _____		
5. Private Claims _____		

DEC 28 4 19 PM '99

Frances Holmbeck
 REGISTER OF DEEDS
 HURON COUNTY, MICHIGAN

Register of Deeds Stamp & File Number

I, James T. Meek, in a field survey on October 30, 1999, do hereby certify that under requirements of P.A. 74, Michigan P.A. of 1970, the corner points mentioned in lines 1 and 2 above were in conformance with regulations and rules thereof as required in the current manual of survey instructions of the United States Department of the Interior, Bureau of Land Management or by a decree of a Court of Law and/or that the corner points mentioned in lines 3, 4 and 5 above were in conformance with the rules of the Michigan Board of Land Surveyors or by a Decree of a Court of Law; established, re-established, monumented, re-monumented, recovered, found as expressed below:

	A	B	C	D	E	F	G	H	I	J	K	L	M
2	6	5	4	3	2	1							
3													
4	7	8	9	10	11	12							
5													
6	18	17	16	15	14	13							
7													
8	19	20	21	22	23	24							
9													
10	30	29	28	27	26	25							
11													
12	31	32	33	34	35	36							
13													


NOTE: Not more than 2 corners, all in the same town and range, may be recorded on this certificate.

A. Description of original monument and accessories and/or subsequent restoration:
 Original survey, South Bdy. T18NR12E, 1835, Harvey Parke D.S.
 A-1 Corner of Townships 17 and 18 North, Ranges 11 and 12 East
 Post
 White Ash 8", N88°W, 9 links
 Aspen 16", S88°E, 10 links
 County Surveyor's Record: axle
 Recorded Surveys: L3, P289
 LCRC: none

REMONUMENTATION
 FEB 02 2000
 SECTION

B. Description of corner evidence found and/or method applied in restoring or reestablishing corner:
 A-1 Corner of Townships 17 and 18 North, Ranges 10 and 11 East
 Found 1 1/4" pipe at intersection of Grassmere and Kinde Roads.
 Accepted as the best available evidence of the original corner position.

C. Description of monument for corner and accessories established to perpetuate locating the position of the corner:
 A-1 Corner of Townships 17 and 18 North, Ranges 10 and 11 East
 1 1/4" pipe in mon box
 From which:
 Tag in power pole bears N45°E, 85.4'
 stop sign post bears S20°E, 37.0'
 Tag in fence post corner bears S40°W, 48.5'
 stop sign post bears N30°W, 37.7'

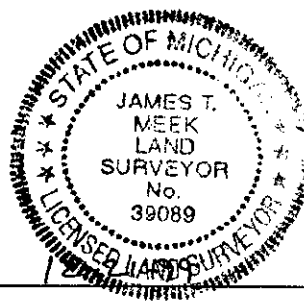

Signed by [Signature] Date _____
 Surveyor's Michigan License No. 39089

APPROVED AT PEER BOARD MEETING 12-16-99 RLB